

STATE ENGINEER.  
Salem, Oregon

# Well Record

STATE WELL NO. 3/1-32A  
COUNTY CLACKAMAS  
APPLICATION NO. GR-2913

**CLAC**  
**012042**

OWNER: Earl Oliver

MAILING ADDRESS:

Box 690


LOCATION OF WELL: Owner's No. #1

CITY AND STATE:

Canby, Oregon

NE 1/4 NE 1/4 Sec. 32 T. 3 N. S., R. 1 E. W., W.M.

Bearing and distance from section or subdivision corner N. 63° 24' W. 1565' from SE cor. Champing Pendleton DLC

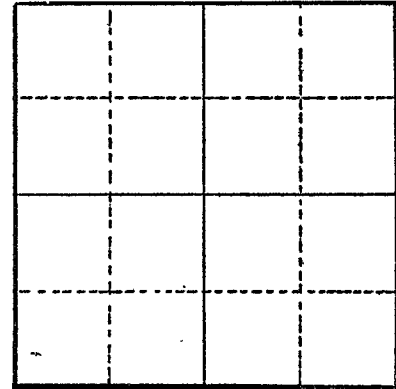

Section .....

Altitude at well .....

TYPE OF WELL: drilled Date Constructed .....

Depth drilled 225 Depth cased 225

CASING RECORD:

6-inch

FINISH:

AQUIFERS:

WATER LEVEL:

PUMPING EQUIPMENT: Type Jacuzzi Turbine H.P. 7 1/2  
Capacity 90 G.P.M.

WELL TESTS:

Drawdown ..... ft. after ..... hours Pumping 85 G.P.M.  
Drawdown ..... ft. after ..... hours ..... G.P.M.

USE OF WATER Irrigation Temp. °F. ...., 19.....

SOURCE OF INFORMATION GR-2742

DRILLER or DIGGER .....

ADDITIONAL DATA:

Log ..... Water Level Measurements ..... Chemical Analysis ..... Aquifer Test .....

REMARKS: