

STATE ENGINEER
Salem, Oregon

CLAC
012043

Well Record


STATE WELL NO. 3/1-32R(2)
COUNTY Clackamas
APPLICATION NO. GR-294

OWNER: City of Canby, Oregon
MAILING ADDRESS: _____

LOCATION OF WELL: Owner's No. 1
CITY AND STATE: Canby, Oregon

SE 1/4 SE 1/4 Sec. 32 T. 3 N. S, R. 1 E. W., W.M.

Bearing and distance from section or subdivision
corner 875' W. and 425' N. from SE corner of
Section 32

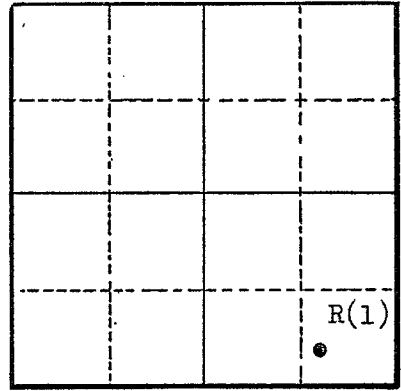

Altitude at well 100' Interpolated

TYPE OF WELL: Dug Date Constructed 1944

Depth drilled 28.4 Depth cased unknown

Section 32

CASING RECORD:

unknown

FINISH:

unknown

AQUIFERS:

unknown

WATER LEVEL:

15' below land surface

PUMPING EQUIPMENT: Type Peerless deep well 8" H.P. 60
Capacity 800 G.P.M.

WELL TESTS:

Drawdown 7 ft. after _____ hours pumping 800 G.P.M.
Drawdown 3 ft. after _____ hours pumping 600 G.P.M.

USE OF WATER Municipal 800 gpm (2 cfs) Temp. _____ °F., 19.
SOURCE OF INFORMATION Registration Statement GR-294

DRILLER or DIGGER unknown

ADDITIONAL DATA:

Log no Water Level Measurements Chemical Analysis Aquifer Test

REMARKS: