

STATE ENGINEER
Salem, Oregon

CLAC
012044

Well Record

STATE WELL NO. 3/1-32R(3)
COUNTY Clackamas
APPLICATION NO. GR-294

OWNER: City of Canby


MAILING
ADDRESS:

LOCATION OF WELL: Owner's No. #2

CITY AND
STATE: Canby, Oregon

SE 1/4 SE 1/4 Sec. 32 T. 3 N. S. R. 1 W. W.M.

Bearing and distance from section or subdivision
corner 775' W. & 425' N. from SE Cor. Sec. 32

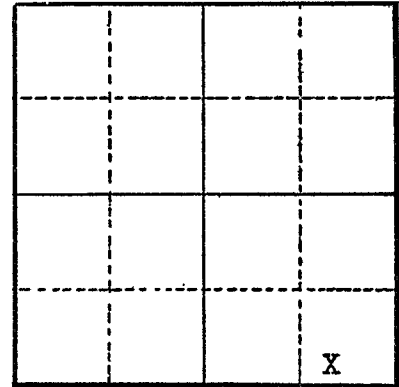

Altitude at well 100 ft. Interpolated

TYPE OF WELL: Dug Date Constructed Unki 1938

Depth drilled 8 ft. Depth cased 8 ft.

Section 32

CASING RECORD: Concrete box 120 ft. long x 2 feet wide x 8 ft. deep

FINISH: none

AQUIFERS: unknown

WATER LEVEL: Unknown

PUMPING EQUIPMENT: Type Fairbanks Morse 3 x 2 H.P. 20
Capacity 200 G.P.M.

WELL TESTS:
Drawdown 8 ft. after hours pumping 400 G.P.M.
Drawdown -- ft. after hours pumping 200 G.P.M.

USE OF WATER Municipal 200 gpm Temp. °F., 19.

SOURCE OF INFORMATION Reg. Statement GR-294

DRILLER or DIGGER

ADDITIONAL DATA:

Log No Water Level Measurements Chemical Analysis Aquifer Test

REMARKS: