

STATE ENGINEER  
Salem, Oregon

CLAC Well Record

STATE WELL NO. 3/1-33M  
COUNTY Clackamas  
APPLICATION NO. GR-3774

012063

OWNER: John R. Meek

MAILING ADDRESS: Box 395


LOCATION OF WELL: Owner's No.

CITY AND STATE: Canby, Oregon

NW 1/4 SW 1/4 Sec. 33 T. 3 N. S., R. 1 E. W.M.

Bearing and distance from section or subdivision

corner N. 90° 30' E. 2240 ft. from SW Cor. Sec. 33

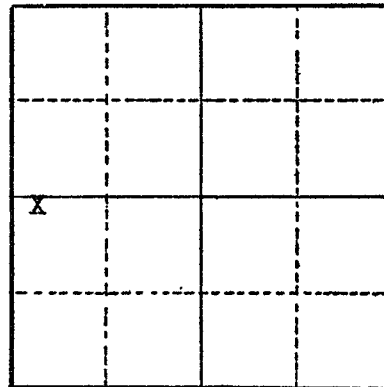

Section 33

Altitude at well

TYPE OF WELL: Drilled Date Constructed 2/8/49

Depth drilled 200 feet Depth cased 200 feet

CASING RECORD:

6 inch casing set to 200 feet

FINISH:

5 perforations per foot per row 3 rows from 90 feet to 100 feet  
5 perforations per foot per row 4 rows from 190 to 200 feet

AQUIFERS:

WATER LEVEL:

53 feet below surface

PUMPING EQUIPMENT: Type Cook turbine H.P. 20  
Capacity 250 G.P.M.

WELL TESTS:

Drawdown 38 ft. after 200 hours G.P.M.  
Drawdown 53 ft. after 250 hours G.P.M.

USE OF WATER Irrigation Temp. °F. 19

SOURCE OF INFORMATION Well Registration Statement

DRILLER or DIGGER

ADDITIONAL DATA:

Log X Water Level Measurements Chemical Analysis Aquifer Test

REMARKS:

342

