

STATE ENGINEER
Salem, Oregon

CLAC
612426

Well Record

STATE WELL NO. 4/1-22N
COUNTY CLACKAMAS
APPLICATION NO. GR-2365

OWNER: Ben Gettmann


MAILING ADDRESS: Rt. 2, Box 252

LOCATION OF WELL: Owner's No.

CITY AND STATE: Canby, Oregon

SW 1/4 SW 1/4 Sec. 22 T. 4 S., R. 1 E. W.M.

Bearing and distance from section or subdivision corner Lying in A. E. Gibble D.L.C. #41.

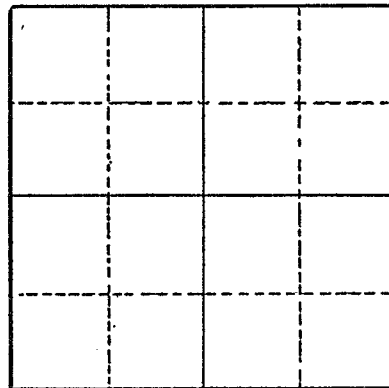

Altitude at well

TYPE OF WELL: Drilled Date Constructed 8/4/51

Depth drilled 300 Depth cased 230

Section

CASING RECORD:

8-inch

FINISH:

Perforations from 75 to 80
Perforations from 135 to 140

Perforations from 160 to 215

AQUIFERS:

Silt, clay and sand

WATER LEVEL:

6-feet

PUMPING EQUIPMENT: Type Cook Rotation H.P. 7.5
Capacity 200 G.P.M.

WELL TESTS:

Drawdown 99 ft. after hours Pumping 100 G.P.M.
Drawdown 200 ft. after hours Pumping 200 G.P.M.

USE OF WATER Irrigation Temp. °F. 19

SOURCE OF INFORMATION GR-2246

DRILLER or DIGGER

ADDITIONAL DATA:

Log Water Level Measurements Chemical Analysis Aquifer Test

REMARKS:

