

STATE ENGINEER  
Salem, Oregon

CLAC

# Well Record

STATE WELL NO. 4/1-28D  
COUNTY CLACKAMAS  
APPLICATION NO. GR-3352

OWNER: Gordon E. Carlson & Evelyn Carlson

012002


MAILING ADDRESS: Rt. 2 Box 110

LOCATION OF WELL: Owner's No. \_\_\_\_\_

CITY AND STATE: \_\_\_\_\_

NW 1/4 NW 1/4 Sec. 28 T. 4 S., R. 1 W., W.M.

Bearing and distance from section or subdivision  
corner 175' S & 400' E from NW cor Sec 28

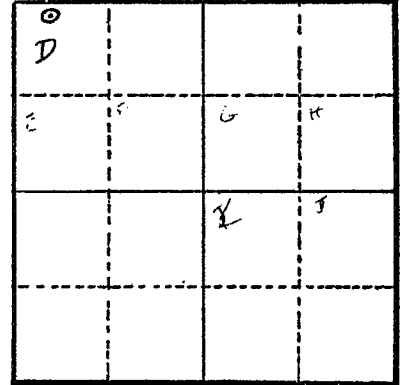

Section 28

Altitude at well \_\_\_\_\_

TYPE OF WELL: Drilled Date Constructed 1955

Depth drilled 147' Depth cased 147'

CASING RECORD:

6-inch Hardened shoe on end of pipe.

FINISH:

5 slots per ft 3 rows

AQUIFERS:

WATER LEVEL:

139'

PUMPING EQUIPMENT: Type Rain flow Centrifugal H.P. 1 1/2  
Capacity 50 G.P.M.

WELL TESTS:

Drawdown 65 ft. after \_\_\_\_\_ hours 80 G.P.M.

Drawdown 93 ft. after \_\_\_\_\_ hours 125 G.P.M.

USE OF WATER Irrigation Temp. \_\_\_\_\_ °F., 19 \_\_\_\_\_

SOURCE OF INFORMATION GR-3871

DRILLER or DIGGER \_\_\_\_\_

ADDITIONAL DATA:

Log  Water Level Measurements \_\_\_\_\_ Chemical Analysis \_\_\_\_\_ Aquifer Test \_\_\_\_\_

REMARKS:

