

STATE ENGINEER
Salem, Oregon

CLAC
012698

Well Record

STATE WELL NO. 4/1-310
COUNTY MARION CLACK
APPLICATION NO. GR-2866

OWNER: John H. Fisher


MAILING ADDRESS: Rt. 1, Box 91

LOCATION OF WELL: Owner's No. _____

CITY AND STATE: Hubbard, Oregon

SW 1/4 SE 1/4 Sec. 31 T. 4 N S., R. 1 E. W., W.M.

Bearing and distance from section or subdivision corner 2073' N. 59° 45' W.

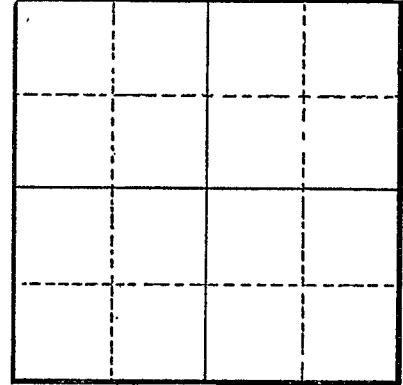

Section _____

Altitude at well _____

TYPE OF WELL: drilled Date Constructed 1951

Depth drilled 110 Depth cased 110

CASING RECORD:

12-inch

FINISH:

AQUIFERS:

WATER LEVEL:

27-feet

PUMPING EQUIPMENT: Type 4" Turbine H.P. 20
Capacity 375 G.P.M.

WELL TESTS:

Drawdown _____ ft. after _____ hours Pumping 375 G.P.M.

Drawdown _____ ft. after _____ hours _____ G.P.M.

USE OF WATER Irrigation Temp. _____ °F. _____, 19.

SOURCE OF INFORMATION GR-2700

DRILLER or DIGGER J. T. Miller - Aurora

ADDITIONAL DATA:

Log _____ Water Level Measurements _____ Chemical Analysis _____ Aquifer Test _____

REMARKS: