

STATE ENGINEER
Salem, Oregon

CLAC
012844

Well Record

STATE WELL NO. 4/1-1R
COUNTY Clackamas
APPLICATION NO. GR-3356

OWNER: Ted Linker


MAILING ADDRESS: Route 1, Box 414

LOCATION OF WELL: Owner's No.

CITY AND STATE: Canby, Oregon

SE 1/4 SE 1/4 Sec. 1 T. 4 N. S. R. 1 E. W.M.

Bearing and distance from section or subdivision
corner 400' W and 300' N.

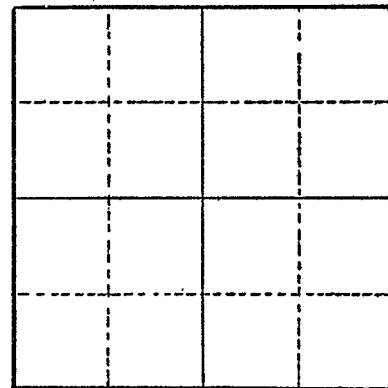

Section

Altitude at well

TYPE OF WELL: drilled Date Constructed 1947

Depth drilled 280' Depth cased

CASING RECORD:

8"

FINISH:

AQUIFERS:

WATER LEVEL:

PUMPING EQUIPMENT: Type Pacific Beresford H.P. 7
Capacity 43 G.P.M.

WELL TESTS:

Drawdown ft. after hours pumping 43 G.P.M.

Drawdown ft. after hours G.P.M.

USE OF WATER Irrigation Temp. °F. 19

SOURCE OF INFORMATION GR-3107

DRILLER or DIGGER

ADDITIONAL DATA:

Log Water Level Measurements Chemical Analysis Aquifer Test

REMARKS: