

STATE ENGINEER
Salem, Oregon

CLAC
012935

Well Record

STATE WELL NO. 4/1-5E
COUNTY Clackamas
APPLICATION NO. GR-3960

OWNER: Richard E. Dye


MAILING ADDRESS: Route 3, Box 257

LOCATION OF WELL: Owner's No. _____

CITY AND STATE: Canby, Oregon

SW 1/4 NW 1/4 Sec. 5 T. 4 N. S, R. 1 E. W., W.M.

Bearing and distance from section or subdivision corner 100 feet North and 180 feet East
from the N1/4 Corner, Section 5.

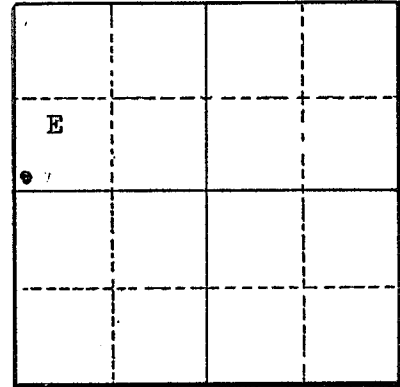

Section 5

Altitude at well _____

TYPE OF WELL: Drilled Date Constructed 1954

Depth drilled 89 feet Depth cased unk

CASING RECORD:

12-inch casing set from top to _____

FINISH:

AQUIFERS:

WATER LEVEL:

9 feet

PUMPING EQUIPMENT: Type Fairbanks Morse H.P. _____

Capacity 100 G.P.M.

WELL TESTS:

Drawdown 22 ft. after _____ hours 100 G.P.M.

Drawdown _____ ft. after _____ hours _____ G.P.M.

USE OF WATER Irrigation Temp. _____ °F., 19 _____

SOURCE OF INFORMATION GR-4053

DRILLER or DIGGER _____

ADDITIONAL DATA:

Log (NA) Water Level Measurements _____ Chemical Analysis _____ Aquifer Test _____

REMARKS: