

STATE ENGINEER
Salem, Oregon

CLAC
012939

Well Record


STATE WELL NO. 4/1-5M(1)
COUNTY Clackamas
APPLICATION NO. G-144

OWNER: City of Barlow
MAILING ADDRESS:

LOCATION OF WELL: Owner's No. CITY AND STATE: Barlow, Oregon

NW 1/4 SW 1/4 Sec. 5 T. 4 S., R. 1 W., W.M.

Bearing and distance from section or subdivision corner 210' S. & 500' E. from W1/4 cor. Sec. 5

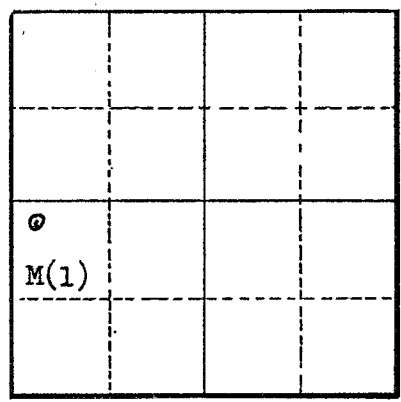

Altitude at well 95 Interpolated

TYPE OF WELL: Drilled Date Constructed 1955

Depth drilled 127 Depth cased 60

Section 5

CASING RECORD:

10 inch casing set from 0 to 60 feet

FINISH:

Well backfilled with gravel to 72 feet

AQUIFERS:

Sand and gravel from 60 to 72 feet

WATER LEVEL:

PUMPING EQUIPMENT: Type _____ H.P. _____
Capacity _____ G.P.M.

WELL TESTS:

Drawdown 50 ft. after 5 hours pumping 150 G.P.M.
Drawdown _____ ft. after _____ hours _____ G.P.M.

USE OF WATER Municipal Temp. _____ °F., 19

SOURCE OF INFORMATION Well Drillers report

DRILLER or DIGGER J.T. Miller

ADDITIONAL DATA:

Log Water Level Measurements _____ Chemical Analysis _____ Aquifer Test _____

REMARKS:

Water Level Record

OWNER: City of Barlow OWNER'S NO. _____

Description of measuring point: Lip of port in pump base on
North Side of Well, 2.0' above LSD

Date	Water Level Feet (above) (below) Land Surface	Remarks	Date	Water Level Feet (above) (below) Land Surface	Remarks
8-15-58	17.0	Final Proof Survey			

REMARKS: _____
