

STATE ENGINEER  
Salem, Oregon

CLAC  
012949

# Well Record

STATE WELL NO. 4/1-6A  
COUNTY CLACKAMAS  
APPLICATION NO. GR-2793

OWNER: Charles H. Smith


MAILING ADDRESS: Barlow, Oregon

LOCATION OF WELL: Owner's No. \_\_\_\_\_

CITY AND STATE: \_\_\_\_\_

NE 1/4 NE 1/4 Sec. 6 T. 4 <sup>N.</sup> S., R. 1 <sup>E.</sup> W., W.M.

Bearing and distance from section or subdivision corner S. 31° W. 1555'

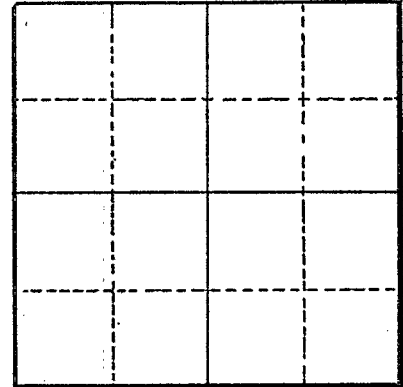

Section \_\_\_\_\_

Altitude at well 100±

TYPE OF WELL: drilled Date Constructed 1950

Depth drilled 200 Depth cased 115

### CASING RECORD:

10-inch

### FINISH:

### AQUIFERS:

Topsoil, gravel, sand, clay and silt

### WATER LEVEL:

8-feet

PUMPING EQUIPMENT: Type Peerless H.P. 20  
Capacity 250 G.P.M.

### WELL TESTS:

Drawdown 80 ft. after \_\_\_\_\_ hours Pumping 250 G.P.M.  
Drawdown \_\_\_\_\_ ft. after \_\_\_\_\_ hours \_\_\_\_\_ G.P.M.

USE OF WATER irrigation Temp. \_\_\_\_\_ °F., 19 \_\_\_\_\_

SOURCE OF INFORMATION GR-2638

### DRILLER or DIGGER \_\_\_\_\_

### ADDITIONAL DATA:

Log  Water Level Measurements \_\_\_\_\_ Chemical Analysis \_\_\_\_\_ Aquifer Test \_\_\_\_\_

### REMARKS:

