

STATE ENGINEER
Salem, Oregon

CLAC
012972

Well Record

STATE WELL NO. 4/1E-7
COUNTY Clackamas
APPLICATION NO. GR-3264

OWNER: Willis Yoder


MAILING ADDRESS: Route 2, Box 18

LOCATION OF WELL: Owner's No. 1-2-4

CITY AND STATE: Aurora, Oregon

NW SE
SW 1/4 NE 1/4 Sec. 7 T. 4 S., R. 1 E. W.M.

Bearing and distance from section or subdivision
corner 35 chs. S. and 25.7 chs. W. of NE Corner
Section 7 41 chs. S. & 38.5 chs. W.
17.4 chs. S. 61.5 chs. W.

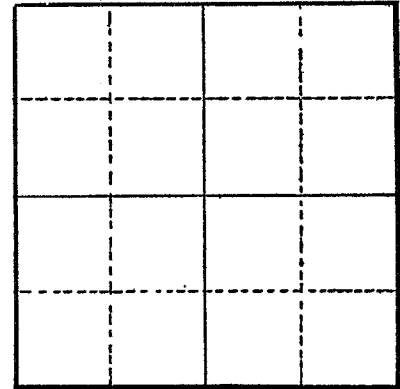

Section

Altitude at well

TYPE OF WELL: trench Date Constructed 1933

Depth drilled 10 1/2 Depth cased

CASING RECORD:

FINISH:

AQUIFERS:

WATER LEVEL:

PUMPING EQUIPMENT: Type Centrifugal H.P. 5
Capacity 100 - 200 G.P.M.

WELL TESTS:

Drawdown ft. after hours G.P.M.
Drawdown ft. after hours G.P.M.

USE OF WATER Irrigation Temp. °F., 19.

SOURCE OF INFORMATION GR-3036

DRILLER or DIGGER

ADDITIONAL DATA:

Log Water Level Measurements Chemical Analysis Aquifer Test

REMARKS: