

STATE ENGINEER
Salem, Oregon

CLAC
012990

Well Record

STATE WELL NO. 4/1-7Q(1)
COUNTY Clackamas
APPLICATION NO. GR-749

OWNER: Courtney G. Pursley
MAILING ADDRESS: Route 2, Box 30

LOCATION OF WELL: Owner's No. 1
CITY AND STATE: Aurora, Oregon


SW 1/4 SE 1/4 Sec. 7 T. 4 N. S. R. 1 W. W.M.

Bearing and distance from section or subdivision
corner 2400' W. & 475' N. from SE cor. Sec. 7

Altitude at well 155' Interpolated

TYPE OF WELL: Drilled Date Constructed Jan '50

Depth drilled 118' Depth cased 118'

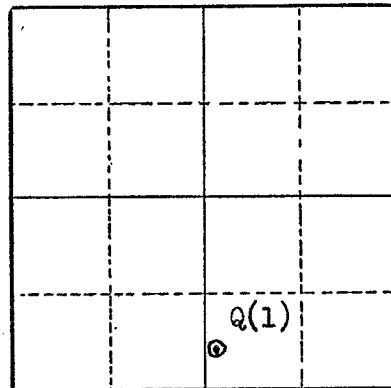

Section 7

CASING RECORD:

8 inch

FINISH:

4 rows of slots from 75' to 117'

AQUIFERS:

WATER LEVEL:

56'

PUMPING EQUIPMENT: Type U.S. Mtrs. Peerless turbine 5 in. H.P. 10
Capacity 200 G.P.M.

WELL TESTS:

Drawdown 4.4 ft. after hours 175 G.P.M.
Drawdown ft. after hours G.P.M.

USE OF WATER Irrigation Temp. °F. 19

SOURCE OF INFORMATION GR-749

DRILLER or DIGGER John Beck Canby

ADDITIONAL DATA:

Log Yes. Water Level Measurements Chemical Analysis Aquifer Test

REMARKS:

