

STATE ENGINEER  
Salem, Oregon

CLAC  
012992

# Well Record

STATE WELL NO. 4/1E-7E  
COUNTY Clackamas  
APPLICATION NO. GR-3263

OWNER: Willis Yoder


MAILING ADDRESS: Route 2, Box 18

LOCATION OF WELL: Owner's No.

CITY AND STATE: Aurora, Oregon

SW 1/4 NW 1/4 Sec. 7 T. 4 S., R. 1 W., W.M.

Bearing and distance from section or subdivision corner 63.4 ch. W. & 32 ch. S. of N.E. cor. Sec. 7

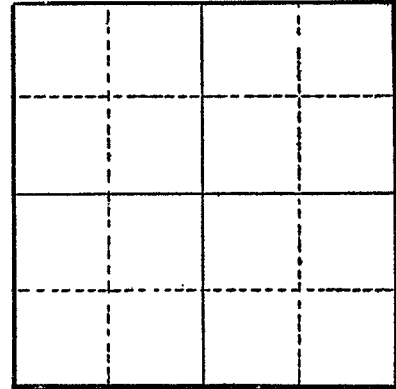

Section

Altitude at well

TYPE OF WELL: drilled Date Constructed 1952

Depth drilled 125 Depth cased 120

### CASING RECORD:

6 inch

### FINISH:

### AQUIFERS:

Sand and fine gravel

### WATER LEVEL:

60 feet

PUMPING EQUIPMENT: Type Turbine H.P. 5

Capacity 90 G.P.M.

### WELL TESTS:

Drawdown 25 ft. after hours Pumping 150 G.P.M.

Drawdown ft. after hours G.P.M.

USE OF WATER Irrigation Temp. °F., 19

SOURCE OF INFORMATION GR-3035

DRILLER or DIGGER J. T. Miller, Aurora, Oregon

### ADDITIONAL DATA:

Log  Water Level Measurements  Chemical Analysis  Aquifer Test

### REMARKS:

Sand 120

Fine Gravel 5