

STATE ENGINEER
Salem, Oregon

CLAC
012999

Well Record

STATE WELL NO. 4/1E-7F
COUNTY Clackamas
~~APPLICATION NO. GR-3265~~

OWNER: Albert C. Workman

MAILING ADDRESS: Route 2, Box 15

LOCATION OF WELL: Owner's No. Sump #3

CITY AND STATE: Aurora, Oregon

SE 1/4 NW 1/4 Sec. 7 T. 4 S., R. 1 E. W.M.

Bearing and distance from section or subdivision


corner 47.8 chs. W. & 35.4 chs. S. of NE Corn.

Section 7

Altitude at well

TYPE OF WELL: trench Date Constructed 1933

Depth drilled 10 1/2 Depth cased

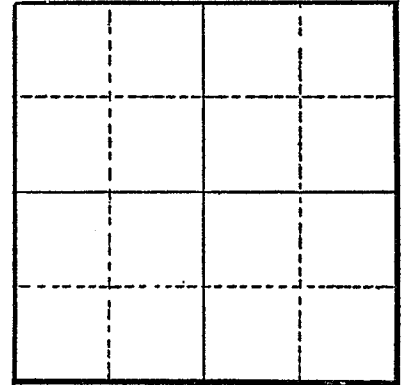

Section

CASING RECORD:

FINISH:

AQUIFERS:

WATER LEVEL:

PUMPING EQUIPMENT: Type Centrifugal H.P. 5
Capacity 100 G.P.M.

WELL TESTS:

Drawdown ft. after hours G.P.M.

Drawdown ft. after hours G.P.M.

USE OF WATER Irrigation Temp. °F., 19.

SOURCE OF INFORMATION GR-3037

DRILLER or DIGGER

ADDITIONAL DATA:

Log Water Level Measurements Chemical Analysis Aquifer Test

REMARKS: