

STATE ENGINEER
Salem, Oregon

CLAC
013004

Well Record

GR- 1696

STATE WELL NO. 4/1-7K
COUNTY Clackamas
APPLICATION NO. GR- 1749

OWNER: Joseph N. Hershberger


MAILING ADDRESS:

LOCATION OF WELL: Owner's No.

CITY AND STATE: Canby, Oregon

NW 1/4 SE 1/4 Sec. 7 T. 4 S., R. 1 E., W.M.

Bearing and distance from section or subdivision corner 1760' W. & 1590' N. from SE cor. Sec. 7

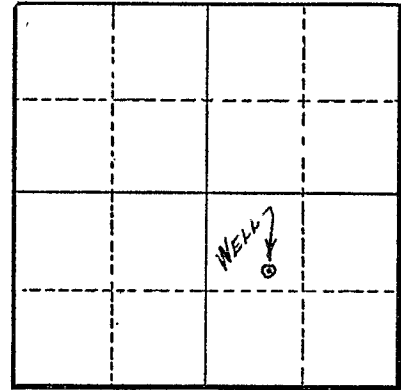

Section 7

Altitude at well 150'

TYPE OF WELL: Drilled Date Constructed 1946

Depth drilled 101' Depth cased 101'

CASING RECORD:
6"

FINISH:

AQUIFERS:

WATER LEVEL:
65'

PUMPING EQUIPMENT: Type Pomona turbine H.P. 3
Capacity 120 G.P.M.

WELL TESTS:
Drawdown 15 ft. after 120 or more hours G.P.M.
Drawdown ft. after hours G.P.M.

USE OF WATER Irrigation Temp. °F., 19

SOURCE OF INFORMATION GR Record

DRILLER or DIGGER J. T. Miller

ADDITIONAL DATA:

Log Water Level Measurements Chemical Analysis Aquifer Test

REMARKS:

Log: Surface 0 to 3 ft.
Surface sand 3 to 68 ft.
Blue clay 68 to 78 ft.
Cement gravel, tight 78 to 86 ft.
Sand 86 to 96 ft.
Gravel water 96 to 101 ft.

Irrigation of 15 acres.