

STATE ENGINEER  
Salem, Oregon

CLAC  
013048

# Well Record

GR- 1609

STATE WELL NO. 4/1-9E  
COUNTY Clackamas  
APPLICATION NO. GR- 1658

OWNER: Lloyd H. Houge


MAILING ADDRESS: Rt. 3, Box 104

LOCATION OF WELL: Owner's No.

CITY AND STATE: Canby, Oregon

SW 1/4 NW 1/4 Sec. 9 T. 4 S., R. 1 E., W.M.

Bearing and distance from section or subdivision corner 480' E. & 1650' S. from NW cor. Sec. 9

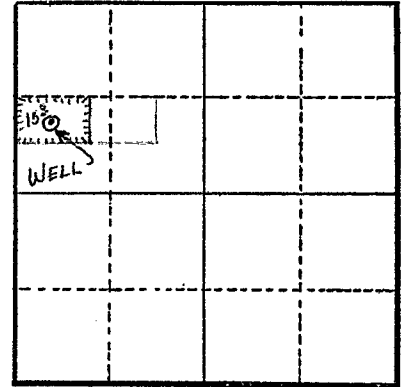

Altitude at well

TYPE OF WELL: Dig Date Constructed 1954

Depth drilled 14' Depth cased 12'

Section 9

### CASING RECORD:

42" concrete pipe

### FINISH:

### AQUIFERS:

Sand & gravel

### WATER LEVEL:

7'

PUMPING EQUIPMENT: Type Berkeley Cent. H.P. 5  
Capacity 100 G.P.M.

### WELL TESTS:

Drawdown 3 ft. after 92 hours G.P.M.

Drawdown ft. after hours G.P.M.

USE OF WATER Irrigation Temp. °F., 19

SOURCE OF INFORMATION GR Record

DRILLER or DIGGER

### ADDITIONAL DATA:

Log N.A. Water Level Measurements Chemical Analysis Aquifer Test

### REMARKS:

Irrigation of 15 acres.