

STATE ENGINEER  
Salem, Oregon

CLAC  
013049 Well Record

STATE WELL NO. 4/1-9F  
COUNTY Clackamas  
APPLICATION NO. GR-3996

OWNER: H. W. Carr


MAILING ADDRESS: Route 3, Box 95

LOCATION OF WELL: Owner's No.

CITY AND STATE: Canby, Oregon

SE 1/4 NW 1/4 Sec. 9 T. 4 S., R. 1 E., W.M.

Bearing and distance from section or subdivision corner 1500' E. & 700' N. from W 1/2 Cor. Sec. 9

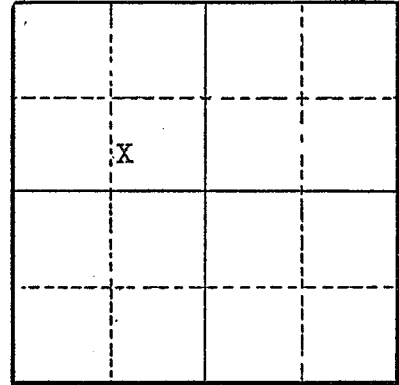

Altitude at well

TYPE OF WELL: Dug Date Constructed July, 1948

Depth drilled 14 ft. Depth cased

Section 9

CASING RECORD:

32 inch inside diameter 4 concrete tile

FINISH:

AQUIFERS:

WATER LEVEL:

12 feet below surface

PUMPING EQUIPMENT: Type Montgomery Ward H.P.  
Capacity 40 to 50 G.P.M.

WELL TESTS:

Drawdown ft. after hours G.P.M.  
Drawdown ft. after hours G.P.M.

USE OF WATER Irrigation Temp. °F., 19

SOURCE OF INFORMATION Well Registration Statement Cert. # GR-3603

DRILLER or DIGGER

ADDITIONAL DATA:

Log X Water Level Measurements Chemical Analysis Aquifer Test

REMARKS:

Log: 3 ft. down to gravel, big rock and gravel from 3 ft. down.