

STATE ENGINEER
Salem, Oregon

CLAC
013050


Well Record

STATE WELL NO. 4/1E - 9P
COUNTY CLACKAMAS
APPLICATION NO. GR-2242

OWNER: Steele's Pansy Gardens, Inc. MAILING ADDRESS: Rt. 3, Box 206

LOCATION OF WELL: Owner's No. CITY AND STATE: Canby, Oregon

SE 1/4 SW 1/4 Sec. 9 T. 4 N. S., R. 1 E. W., W.M.
Bearing and distance from section or subdivision
corner 1710' W. and 400' N.

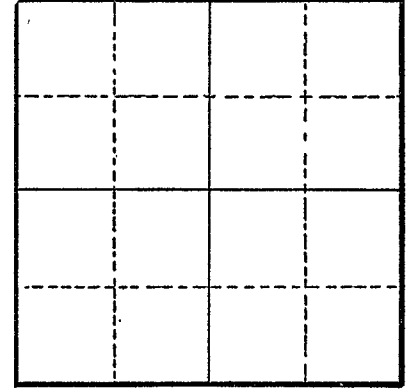

Section

Altitude at well

TYPE OF WELL: Drilled Date Constructed 1950
Depth drilled 155 Depth cased 155

CASING RECORD:

8-Inch

FINISH:

Perforations from 137 to 142
Perforations from 146 to bottom

AQUIFERS:

Silt

WATER LEVEL:

32-Feet

PUMPING EQUIPMENT: Type Peerless Turbine H.P. 7 1/2
Capacity 160 G.P.M.

WELL TESTS:

Drawdown 68 ft. after hours Pumping 300 G.P.M.
Drawdown ft. after hours G.P.M.

USE OF WATER Irrigation Temp. °F. 19

SOURCE OF INFORMATION GR-2143

DRILLER or DIGGER John Beck, Canby, Oregon

ADDITIONAL DATA:

Log Water Level Measurements Chemical Analysis Aquifer Test

REMARKS:

