

STATE ENGINEER  
Salem, Oregon


CLAC  
013180

# Well Record

STATE WELL NO. 4/1-15  
COUNTY CLACKAMAS  
~~APPLICATION NO.~~ GR-2481

OWNER: Henry Ganske & I, Hazel Ganske, his wife  
MAILING ADDRESS: Rt. 3, Box 185,  
CITY AND STATE: Canby, Oregon

NE<sup>1</sup>/<sub>4</sub> SE 1/4 NW 1/4 Sec. 15 T. 4 N. S. R. 1 E. W.M.  
Bearing and distance from section or subdivision  
corner Approx. 120 rods S.

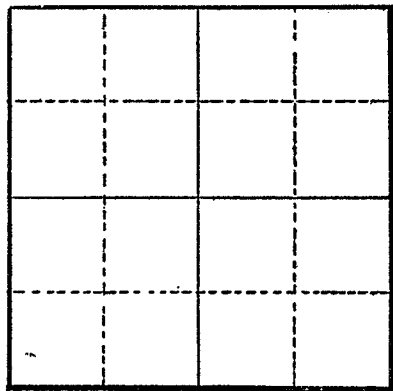

Section

Altitude at well

TYPE OF WELL: Dug Date Constructed 1951  
Depth drilled 27 Depth cased 27

### CASING RECORD:

96-inch  
72-inch

### FINISH:

18 -- 1/2 x 6 in. from 22 to 27

### AQUIFERS:

Willamette, clay and sand

### WATER LEVEL:

14-feet

PUMPING EQUIPMENT: Type Pacific Centrifugal H.P. 7 1/2  
Capacity 175 G.P.M.

### WELL TESTS:

Drawdown 5 ft. after hours Pumping 100 G.P.M.  
Drawdown 9 ft. after hours Pumping 150 G.P.M.

USE OF WATER Irrigation Temp. °F., 19

SOURCE OF INFORMATION GR-2349

DRILLER or DIGGER

### ADDITIONAL DATA:

Log  Water Level Measurements Chemical Analysis Aquifer Test

### REMARKS:

Willamette	2	2
Clay	12	14
Sand	13	27