

STATE ENGINEER
Salem, Oregon

CLAC
013182

Well Record

STATE WELL NO. 4/1-15
COUNTY CLACKAMAS
~~APPLICATION NO:~~ GR-2480

OWNER: William Meyer, and Annie Meyer,
his wife

MAILING ADDRESS: Rt. 3, Box 187,


LOCATION OF WELL: Owner's No. _____

CITY AND STATE: Canby, Oregon

NW¹/₄

SW ¹/₄ NW ¹/₄ Sec. 15 T. 4 ^N/_S, R. 1 ^E/_W, W.M.

Bearing and distance from section or subdivision
corner Approx. 110 rods S. & 35 rods E.

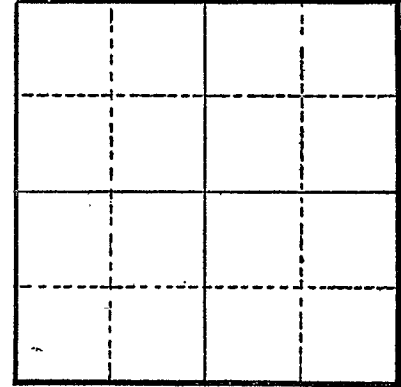

Section _____

Altitude at well _____

TYPE OF WELL: Dug Date Constructed 1951

Depth drilled 30 Depth cased _____

CASING RECORD:

72-inch

FINISH:

AQUIFERS:

Amity, Willamette, Clay and Gravel

WATER LEVEL:

14-feet

PUMPING EQUIPMENT: Type Pipe, Pump and Power 1 1/2 in. H.P. 5
Capacity 125 G.P.M.

WELL TESTS:

Drawdown 5 ft. after _____ hours Pumping 90 G.P.M.
Drawdown 20 ft. after _____ hours Pumping 125 G.P.M.

USE OF WATER Irrigation Temp. _____ °F., 19 _____

SOURCE OF INFORMATION GR-2348

DRILLER or DIGGER _____

ADDITIONAL DATA:

Log Water Level Measurements _____ Chemical Analysis _____ Aquifer Test _____

REMARKS:

Amity 2 2
Willamette 3 5
Clay 8 13
Gravel 17 30