

STATE ENGINEER
Salem, Oregon

CLAC
013211

Well Record


STATE WELL NO. 4/1-15C
COUNTY Clackamas
APPLICATION NO. GR-3720

OWNER: Rufus Kraxberger, Jr.
MAILING ADDRESS: Route 5, Box 184
CITY AND STATE: Canby, Oregon

LOCATION OF WELL: Owner's No.
NE 1/4 NW 1/4 Sec. 15 T. 4 S. R. 1 W., W.M.

Bearing and distance from section or subdivision

corner 30' N. & 15' E. of pipe in road which is
SW Cor. NE 1/4 NW 1/4 Sec. 15

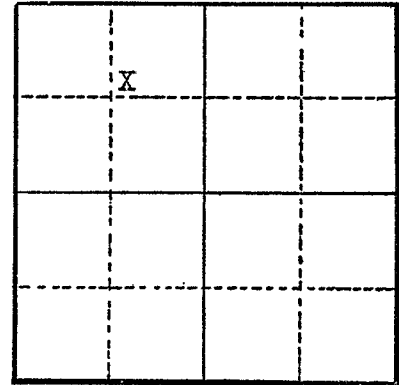

Altitude at well

TYPE OF WELL: Dug Date Constructed Oct., 1952

Depth drilled 30 feet Depth cased 30 feet

Section 15

CASING RECORD:

60 inch casing set to 30 feet

FINISH:

30 - 1" x 5" holes cut in tubing from 15 to 30 feet

AQUIFERS:

WATER LEVEL:

9 feet below surface

PUMPING EQUIPMENT: Type Jacuzzi centrifugal H.P. 10
Capacity 250 G.P.M.

WELL TESTS:

Drawdown 20 ft. after hours 225 G.P.M.

Drawdown ft. after hours G.P.M.

USE OF WATER Irrigation Temp. °F. 19

SOURCE OF INFORMATION Well Registration Statement

DRILLER or DIGGER

ADDITIONAL DATA:

Log X Water Level Measurements Chemical Analysis Aquifer Test

REMARKS:

Log:

Top soil Amity
Clay
Black sand

3455