

STATE ENGINEER
Salem, Oregon

CLAC

Well Record

STATE WELL NO. 4/1-16A
COUNTY CLACKAMAS
APPLICATION NO. GR-2567

013250

OWNER: John H. Gelbrich

MAILING
ADDRESS: Rt. 3, Box 204


LOCATION OF WELL: Owner's No. _____

CITY AND
STATE: Canby, Oregon

NE $\frac{1}{4}$ NE $\frac{1}{4}$ Sec. 16 T. 4 N S., R. 1 E. W., W.M.

Bearing and distance from section or subdivision

corner 950' W. & 25' S.

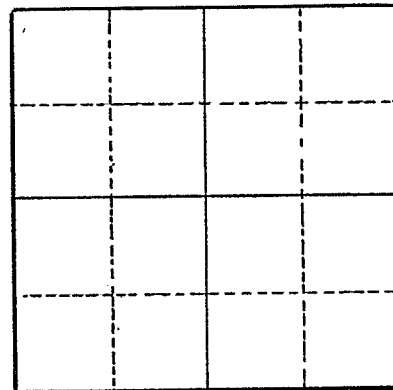

Altitude at well _____

TYPE OF WELL: Dug Date Constructed 1950

Depth drilled 31 Depth cased 31

Section _____

CASING RECORD:

60-inch

FINISH:

AQUIFERS:

Sand and gravel

WATER LEVEL:

12-feet

PUMPING EQUIPMENT: Type Berkeley H.P. 3
Capacity 100 G.P.M.

WELL TESTS:

Drawdown _____ ft. after _____ hours Pumping 100 G.P.M.

Drawdown _____ ft. after _____ hours _____ G.P.M.

USE OF WATER Irrigation Temp. _____ °F., 19.

SOURCE OF INFORMATION GR-2426

DRILLER or DIGGER Christy

ADDITIONAL DATA:

Log X Water Level Measurements _____ Chemical Analysis _____ Aquifer Test _____

REMARKS:

Sand & gravel