

STATE ENGINEER
Salem, Oregon

CLAC

Well Record

013251 GR- 1408

STATE WELL NO. 4/1-16A
COUNTY Clackamas
APPLICATION NO. GR- 1459

OWNER: Louis C. Gelbrich

MAILING
ADDRESS: Rt. 3, Box 194


LOCATION OF WELL: Owner's No.

CITY AND
STATE: Canby, Oregon

NE 1/4 NE 1/4 Sec. 16 T. 4 S. R. 1 E. W.M.

Bearing and distance from section or subdivision

corner 200' S. & 60' W. from NE cor. Sec. 16

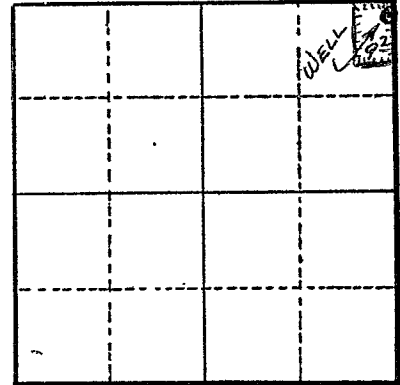

Altitude at well

TYPE OF WELL: Dug Date Constructed 1954

Depth drilled 18' Depth cased 10'

Section 16

CASING RECORD:

8' x 11' plank cribbing

FINISH:

AQUIFERS:

WATER LEVEL:

4 ft.

PUMPING EQUIPMENT: Type Cent.

H.P. 2

Capacity 50 G.P.M.

WELL TESTS:

Drawdown 5 ft. after 24 hours 50 G.P.M.

Drawdown ft. after hours G.P.M.

USE OF WATER Irrigation Temp. °F. 19.

SOURCE OF INFORMATION GR Record

DRILLER or DIGGER

ADDITIONAL DATA:

Log Water Level Measurements Chemical Analysis Aquifer Test

REMARKS:

Log: Soil, sand, clay & hard pan 0 to 12 ft.
Sand & gravel 12 to 18 ft.
Hard pan below this level

Irrigation of 9.2 acres.