

STATE ENGINEER
Salem, Oregon

CLAC

Well Record
013254

STATE WELL NO. 4/1-16B
COUNTY Clackamas
APPLICATION NO. GR-4269

OWNER: Nels Dotseth


MAILING
ADDRESS: Route 3, Box 208

LOCATION OF WELL: Owner's No.

CITY AND
STATE: Canby, Oregon

NW 1/4 NE 1/4 Sec. 16 T. 4 N. S. R. 1 E. W.M.

Bearing and distance from section or subdivision
corner 886 feet South of North boundry of Section 16,
1336 feet West of Northeast corner of Section 16.

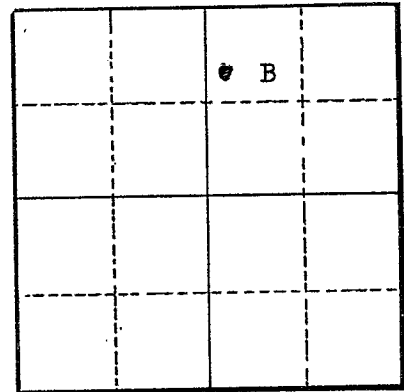

Altitude at well 70 feet

TYPE OF WELL: Dug Date Constructed July 1946

Depth drilled 35 feet Depth cased 35 feet

Section 16

CASING RECORD:

72-inch concrete casing from 0 to 35 feet

FINISH:

AQUIFERS:

sand and gravel

WATER LEVEL:

17 feet

PUMPING EQUIPMENT: Type Berkeley Pump H.P.
Capacity 150 G.P.M.

WELL TESTS:

Drawdown 13 ft. after hours 150 G.P.M.

Drawdown ft. after hours G.P.M.

USE OF WATER Irrigation Temp. °F. 19

SOURCE OF INFORMATION GR-4120

DRILLER or DIGGER Leonard Johnson and Pete Bolland Canby, Oregon

ADDITIONAL DATA:

Log ☒ Water Level Measurements Chemical Analysis Aquifer Test

REMARKS:

top soil and sand blue clay 23 12
sand and gravel - water bearing 12 0