

STATE ENGINEER
Salem, Oregon

CLAC

013264

Well Record

STATE WELL NO. 4/1-16H
COUNTY CLACKAMAS
~~APPLICATION NO.~~ GR-2568

OWNER: John H. Galbrich


MAILING ADDRESS: Rt. 3, Box 204

LOCATION OF WELL: Owner's No.

CITY AND STATE: Canby, Oregon

SE 1/4 NE 1/4 Sec. 16 T. 4 N. S. R. 1 E. W. W.M.

Bearing and distance from section or subdivision corner 10' N. & 450' E.

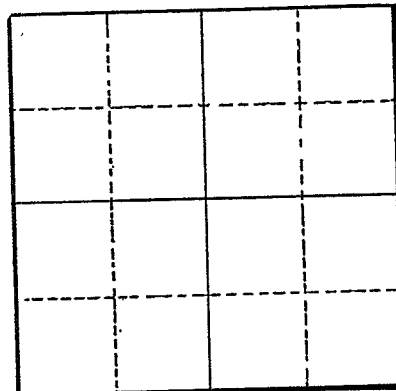

Altitude at well

TYPE OF WELL: Dug Date Constructed 1948

Depth drilled 31 Depth cased 31

Section

CASING RECORD:

60-inch

FINISH:

AQUIFERS:

Sand & gravel

WATER LEVEL:

10-feet

PUMPING EQUIPMENT: Type Berkley H.P. 3
Capacity 100 G.P.M.

WELL TESTS:

Drawdown ft. after hours Pumping 100 G.P.M.
Drawdown ft. after hours G.P.M.

USE OF WATER Irrigation Temp. °F., 19

SOURCE OF INFORMATION GR-2427

DRILLER or DIGGER

ADDITIONAL DATA:

Log Water Level Measurements Chemical Analysis Aquifer Test

REMARKS:

Sand & gravel