

STATE ENGINEER
Salem, Oregon

CLAC Well Record

STATE WELL NO. 4/1-18F
COUNTY Clackamas
APPLICATION NO. GR-1570

013326

GR-1512

OWNER: William Geisler


MAILING ADDRESS: Rt. 2, Box 80

LOCATION OF WELL: Owner's No. #1

CITY AND STATE: Aurora, Oregon

SE 1/4 NW 1/4 Sec. 18 T. 4 XXX S., R. 1 XX E. W.M.

Bearing and distance from section or subdivision corner 1600' S. & 1800' E. from NW cor. Sec. 18

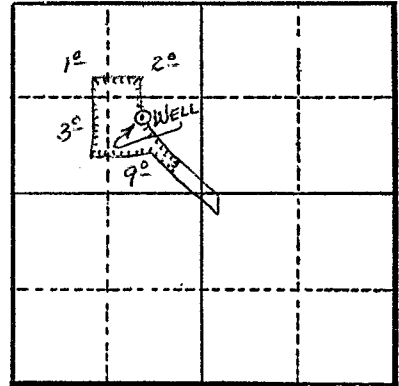

Section 18

Altitude at well

TYPE OF WELL: Drilled Date Constructed 1950

Depth drilled 105' Depth cased 105'

CASING RECORD:

6"

FINISH:

Perforated with Mills knife slots from 95 to 105 ft.

AQUIFERS:

WATER LEVEL:

50'

PUMPING EQUIPMENT: Type F. M. turbine H.P. 5
Capacity 85 G.P.M.

WELL TESTS:

Drawdown ft. after hours G.P.M.
Drawdown ft. after hours G.P.M.

USE OF WATER Irrigation Temp. °F., 19

SOURCE OF INFORMATION GR Record

DRILLER or DIGGER John Beck

ADDITIONAL DATA:

Log N.A. Water Level Measurements Chemical Analysis Aquifer Test

REMARKS:

Materials consist of sands & clay.

Irrigation of 15 acres.