

STATE ENGINEER
Salem, Oregon

CLAC Well Record
013336

STATE WELL NO. 4/1-18B
COUNTY CLACKAMAS
APPLICATION NO. GR-2466

OWNER: Myron M. Pursley


MAILING ADDRESS: Rt. 2, Box 29-B

LOCATION OF WELL: Owner's No. _____

CITY AND STATE: Aurora, Oregon

N W
NW NE SE SW Sec. 18 T. 4 S., R. 1 W., W.M.

Bearing and distance from section or subdivision corner 290' E. and 550' S.

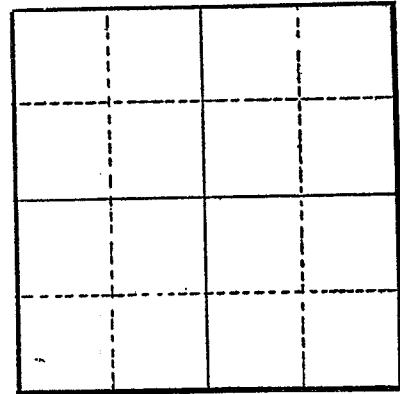

Section _____

Altitude at well _____

TYPE OF WELL: Drilled Date Constructed 1948

Depth drilled 119 Depth cased 119

CASING RECORD:

6-inch

FINISH:

8 perforations per foot 1/4 wide from 92 to 96

AQUIFERS:

WATER LEVEL:

40 to 60 feet

PUMPING EQUIPMENT: Type Fairbanks Morse Turbine H.P. 5
Capacity 60 G.P.M.

WELL TESTS:
Drawdown 10 ft. after _____ hours Pumping 70 G.P.M.
Drawdown 30 ft. after _____ hours Pumping 90 G.P.M.

USE OF WATER Irrigation Temp. _____ °F., 19____

SOURCE OF INFORMATION GR-2336

DRILLER or DIGGER Unknown well deepened by John T. Miller

ADDITIONAL DATA:
Log _____ Water Level Measurements _____ Chemical Analysis _____ Aquifer Test _____

REMARKS: