

STATE ENGINEER
Salem, Oregon

CLAG

013767

Well Record

STATE WELL NO. ^{4/2} - 9B
COUNTY CLACKAMAS
~~APPLICATION NO. GR-1956~~

OWNER: Henry Schoenborn

MAILING

ADDRESS: Rt. 1, Box 18

LOCATION OF WELL: Owner's No.


CITY AND

STATE: Mulino, Oregon

NW $\frac{1}{4}$ NE $\frac{1}{4}$ Sec. 9 T. 4 S., R. 2 E., W.M.

Bearing and distance from section or subdivision

corner 650' from NW $\frac{1}{4}$ NE $\frac{1}{4}$

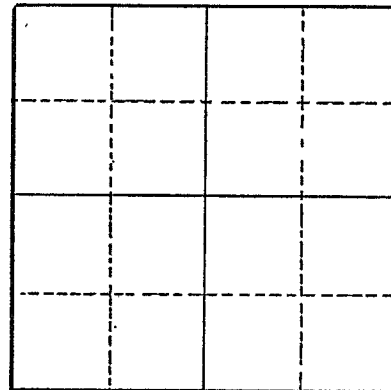

Section

Altitude at well

TYPE OF WELL: Drilled Date Constructed 1951

Depth drilled 100 Depth cased 100

CASING RECORD:

8-inch

FINISH:

AQUIFERS:

WATER LEVEL:

45 feet

PUMPING EQUIPMENT: Type Fairbanks Morse H.P. 3
Capacity 100 G.P.M.

WELL TESTS:

Drawdown ft. after hours G.P.M.

Drawdown ft. after hours G.P.M.

USE OF WATER Irrigation Temp. °F. 19

SOURCE OF INFORMATION GR-1882

DRILLER or DIGGER Wm. Wilson Rt. 1, Beavercreek, Oregon

ADDITIONAL DATA:

Log Water Level Measurements Chemical Analysis Aquifer Test

REMARKS: