

STATE ENGINEER
Salem, Oregon

CLAC
014003

Well Record

STATE WELL NO. 4/2-20A
COUNTY Clackamas
APPLICATION NO. GR-4146

OWNER: Mulino Municipal Water District

MAILING

ADDRESS: Mulino

LOCATION OF WELL: Owner's No.

CITY AND

STATE: Oregon

NE 1/4 NE 1/4 Sec. 20 T. 4 N. S., R. 2 E. W., W.M.


Bearing and distance from section or subdivision

corner 650' W. of SE cor of NE 1/4 NE 1/4

Altitude at well

TYPE OF WELL: Drilled Date Constructed 1939

Depth drilled 190 Depth cased 190

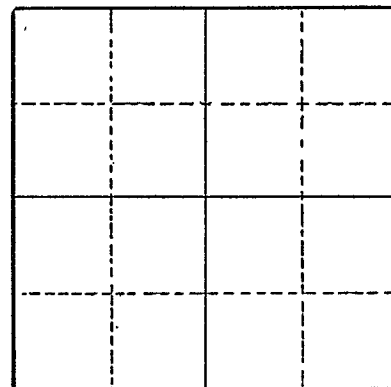

Section 20

CASING RECORD:

6-inch, 0 to 190 feet

FINISH:

Unknown

AQUIFERS:

Unknown

WATER LEVEL:

Unknown

PUMPING EQUIPMENT: Type Pierce 3 phase H.P. 10
Capacity 50 G.P.M.

WELL TESTS:

Drawdown ft. after hours G.P.M.

Drawdown ft. after hours G.P.M.

USE OF WATER Municipal water system Temp. °F., 19

SOURCE OF INFORMATION GR-4146

DRILLER or DIGGER

ADDITIONAL DATA:

Log Water Level Measurements Chemical Analysis Aquifer Test

REMARKS: