

STATE ENGINEER
Salem, Oregon

CLAC Well Record
014004

STATE WELL NO. 4/2-20H
COUNTY Clackamas
APPLICATION NO. GR-4147

OWNER: Mulino Municipal Water District


MAILING ADDRESS: Mulino

LOCATION OF WELL: Owner's No. _____

CITY AND STATE: Oregon

SE 1/4 NE 1/4 Sec. 20 T. 4 ^{N.} S., R. 2 ^{E.} W., W.M.

Bearing and distance from section or subdivision corner 500' W. of SE cor. of SE 1/4 NE 1/4

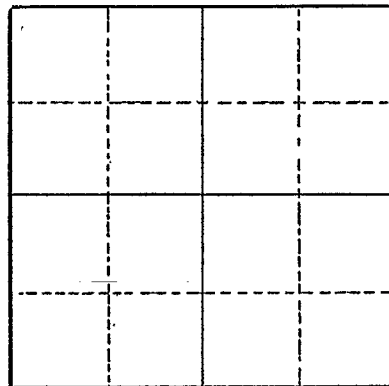

Section 20

Altitude at well _____

TYPE OF WELL: Drilled Date Constructed 1952

Depth drilled 300 Depth cased 300

CASING RECORD:

8-inch, 0 to 300 feet

FINISH:

Unknown

AQUIFERS:

Unknown

WATER LEVEL:

Unknown

PUMPING EQUIPMENT: Type Pierce turbine 3 phase H.P. 15
Capacity 100 G.P.M.

WELL TESTS:

Drawdown _____ ft. after _____ hours _____ G.P.M.

Drawdown _____ ft. after _____ hours _____ G.P.M.

USE OF WATER Municipal water system Temp. _____ °F. _____, 19_____

SOURCE OF INFORMATION GR-4147

DRILLER or DIGGER _____

ADDITIONAL DATA:

Log _____ Water Level Measurements _____ Chemical Analysis _____ Aquifer Test _____

REMARKS: