

STATE ENGINEER
Salem, Oregon

CLAG
014214

Well Record

STATE WELL NO. 4/2-29A
COUNTY Clackamas
APPLICATION NO. GR-2062

OWNER: M. A. Wheeler MAILING ADDRESS: Route 1, Box 118

LOCATION OF WELL: Owner's No. _____ CITY AND STATE: Mulino, Oregon


_____ $\frac{1}{4}$ _____ $\frac{1}{4}$ Sec. _____ T. _____ N. _____ E. _____ S., R. _____ W., W.M.

Bearing and distance from section or subdivision corner 740' W. and 1110' S.

Altitude at well _____

TYPE OF WELL: Dug Date Constructed 1950

Depth drilled 10 Depth cased 10

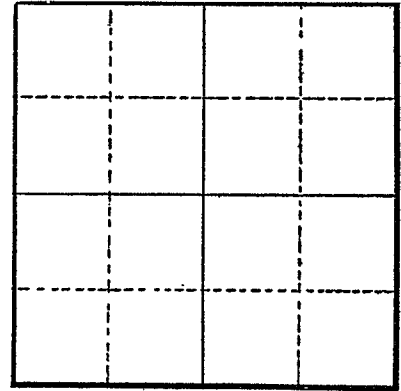

Section _____

CASING RECORD:

36 inch

FINISH:

AQUIFERS:

Top soil, sand and gravel

WATER LEVEL:

7.5 feet

PUMPING EQUIPMENT: Type Goulds centrifugal H.P. 5
Capacity 100 G.P.M.

WELL TESTS:

Drawdown _____ ft. after _____ hours _____ G.P.M.
Drawdown _____ ft. after _____ hours _____ G.P.M.

USE OF WATER Irrigation Temp. _____ °F., 19 _____

SOURCE OF INFORMATION GR-1985

DRILLER or DIGGER _____

ADDITIONAL DATA:

Log Water Level Measurements _____ Chemical Analysis _____ Aquifer Test _____

REMARKS:

Top soil 5' 5'
Sand & gravel 5' 10'