

STATE ENGINEER  
Salem, Oregon

CLAC

Well Record

STATE WELL NO. 4/2-29H  
COUNTY CLACKAMAS  
APPLICATION NO. GR-2020

014215

OWNER: Richard P. Ressel


MAILING ADDRESS:

LOCATION OF WELL: Owner's No.

CITY AND STATE: Mulino

SE 1/4 NE 1/4 Sec. 29 T. 4 S., R. 2 E., W.M.

Bearing and distance from section or subdivision corner about 1720' S & 370' W from NE corner section 29

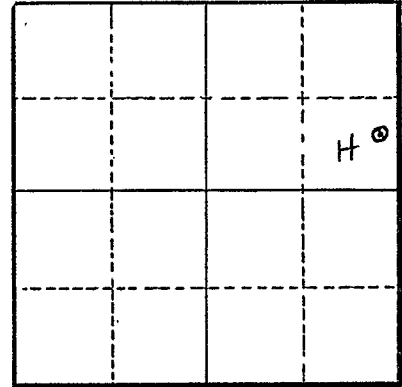

Section 29

Altitude at well

TYPE OF WELL: Dug Date Constructed 1930

Depth drilled 16' Depth cased

CASING RECORD:

FINISH:

AQUIFERS:

WATER LEVEL:

14'

PUMPING EQUIPMENT: Type WESCO TURBINE Capacity 60 G.P.M.

H.P. 3

WELL TESTS:

Drawdown 3 ft. after 3600 hours G.P.M.

Drawdown ft. after hours G.P.M.

USE OF WATER Watering nursery & greenhouse Temp. °F. 19

SOURCE OF INFORMATION GR-3851

DRILLER or DIGGER NA

ADDITIONAL DATA:

Log NA Water Level Measurements Chemical Analysis Aquifer Test

REMARKS: