

STATE ENGINEER
Salem, Oregon


CLAC
014667 Well Record

STATE WELL NO. 3/4-26L(1)
COUNTY Clackamas
APPLICATION NO. GR-465

OWNER: Fred M. Pickering MAILING ADDRESS:

LOCATION OF WELL: Owner's No. CITY AND STATE: Estacada, Oregon

NE 1/4 SW 1/4 Sec. 26 T. 3 N. S., R. 4 E. W., W.M.
Bearing and distance from section or subdivision
corner 160' E. & 351' N. from SW cor of NE 1/4 SW 1/4

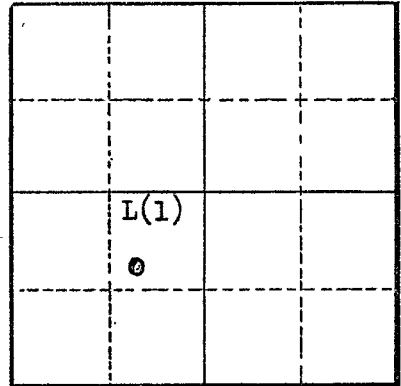

Altitude at well 1100

TYPE OF WELL: Drilled Date Constructed Aug. 55

Depth drilled 100 Depth cased 57 1/2

Section 26

CASING RECORD:

8 inch

FINISH:

AQUIFERS:

WATER LEVEL:

5

PUMPING EQUIPMENT: Type _____ H.P. _____
Capacity _____ G.P.M.

WELL TESTS:

Drawdown 80 ft. after _____ hours 70 G.P.M.
Drawdown _____ ft. after _____ hours _____ G.P.M.

USE OF WATER Irrigation 15 acres Temp. _____ °F. _____, 19

SOURCE OF INFORMATION GR-465

DRILLER or DIGGER _____

ADDITIONAL DATA:

Log Water Level Measurements _____ Chemical Analysis _____ Aquifer Test _____

REMARKS:

