

015126

OWNER: Ray Schaefer


MAILING ADDRESS: Route 2, Box 220

LOCATION OF WELL: Owner's No.

CITY AND STATE: Woodburn, Oregon

NE 1/4 NW 1/4 Sec. 4 T. 6 N. S., R. 1 E. W.M.

Bearing and distance from section or subdivision corner S. 51° E. 2100 feet from NW. Corner of Sec. 4

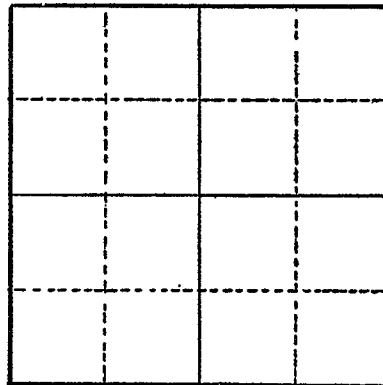

Section

Altitude at well

TYPE OF WELL: drilled Date Constructed 1953

Depth drilled 160' Depth cased

CASING RECORD:

6"

FINISH:

AQUIFERS:

soil, silt, gravel, boulders clay and rock

WATER LEVEL:

33'

PUMPING EQUIPMENT: Type H.P. 7 1/2
Capacity 100 G.P.M.

WELL TESTS:

Drawdown ft. after hours pumping 100 G.P.M.
Drawdown ft. after hours G.P.M.

USE OF WATER irrigation Temp. °F. 19

SOURCE OF INFORMATION GR-3066

DRILLER or DIGGER

ADDITIONAL DATA:

Log x Water Level Measurements Chemical Analysis Aquifer Test

REMARKS:

Top soil and brown silt	0	18
Blue silt	18	24
cement gravel, small boulders	24	36
blue clay	36	44
brown and blue clay mixed	44	60
blue rock	60	157