

STATE ENGINEER  
Salem, Oregon

**CLAC Well Record**  
**015154** GR- 1396

STATE WELL NO. 6/1-5A  
COUNTY Clackamas  
APPLICATION NO. GR- 1449

OWNER: Donald R. Meyer


MAILING ADDRESS: Rt. 2, Box 216

LOCATION OF WELL: Owner's No.

CITY AND STATE: Woodburn, Oregon

NE 1/4 NE 1/4 Sec. 5 T. 6 S., R. 1 E., W.M.

Bearing and distance from section or subdivision  
corner 750' W. & 150' S. from NE cor. Sec. 5.

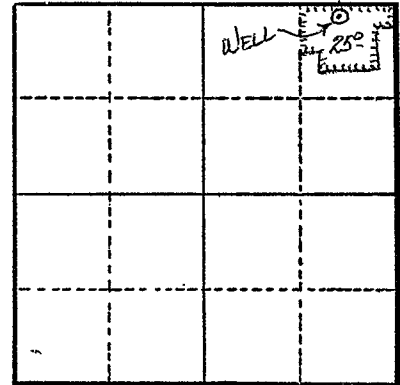

Section 5

Altitude at well

TYPE OF WELL: Drilled Date Constructed 1952

Depth drilled 175' Depth cased 124'

CASING RECORD:  
6"

FINISH:

AQUIFERS:

Some water at 110'  
Present supply struck at 135'

WATER LEVEL:

135'

PUMPING EQUIPMENT: Type 4 stage Universal jet H.P. 3

Capacity 16 G.P.M.

WELL TESTS:

Drawdown 100 ft. after 20 hours G.P.M.

Drawdown 135 ft. after 20 hours G.P.M.

USE OF WATER Irrigation Temp. °F., 19

SOURCE OF INFORMATION GR Record

DRILLER or DIGGER Perkins

ADDITIONAL DATA:

Log Water Level Measurements Chemical Analysis Aquifer Test

REMARKS:

Log: Reddish clay 0 to 90'  
Blue clay 90' to 105'  
Clay, mud & sand 105' to 110'  
Hard blue clay 110' to 160'  
Hard blue shale 160' to 175'

Irrigation of 25 acres.