

STATE ENGINEER  
Salem, Oregon

CLAC Well Record

015155

STATE WELL NO. 6/1-5G(1)  
COUNTY Clackamas  
APPLICATION NO. GR-185

OWNER: Emil H. Jacobson


MAILING ADDRESS: Route 1

LOCATION OF WELL: Owner's No. #1

CITY AND STATE: Mt. Angel, Oregon

SW 1/4 NE 1/4 Sec. 5 T. 6 N. S, R. 1 E, W.M.

Bearing and distance from section or subdivision corner 150' N. & 970' E. from center Sec. 5

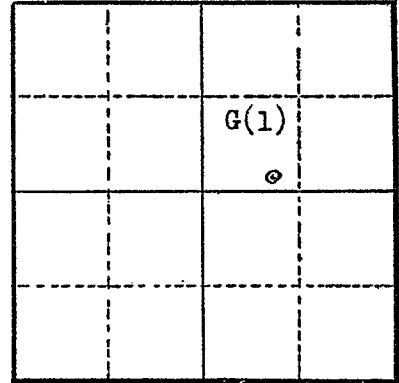

Section 5

Altitude at well 275' Interpolated

TYPE OF WELL: Drilled Date Constructed 1949

Depth drilled 203' Depth cased 160'

CASING RECORD:

8 inch casing set from 0 to 160 feet

FINISH:

None

AQUIFERS:

Unknown

WATER LEVEL:

161 ?

PUMPING EQUIPMENT: Type Peerless Turbine H.P. 7 1/2  
Capacity 85 G.P.M.

WELL TESTS:

Drawdown 140? ft. after hours pumping 85 G.P.M.  
Drawdown ft. after hours G.P.M.

USE OF WATER Irrigation 30 acres Temp. °F. 19

SOURCE OF INFORMATION Registration Statement GR-185

DRILLER or DIGGER Byron Ballweber

ADDITIONAL DATA:

Log No Water Level Measurements Chemical Analysis Aquifer Test

REMARKS: