

STATE ENGINEER
Salem, Oregon

CLAC Well Record
CLAC
015185


STATE WELL NO. 6/1-9B(1)
COUNTY Clackamas
APPLICATION NO. GR-316

OWNER: Orrin S. Rice MAILING ADDRESS: Route 1, Box 44

LOCATION OF WELL: Owner's No. 1 CITY AND STATE: Mt. Angel, Oregon

NW 1/4 NE 1/4 Sec. 9 T. 6 S., R. 1 W., W.M.

Bearing and distance from section or subdivision
corner 145 rds W. & 47.5 rds S. of the NE cor.
Sec. 9

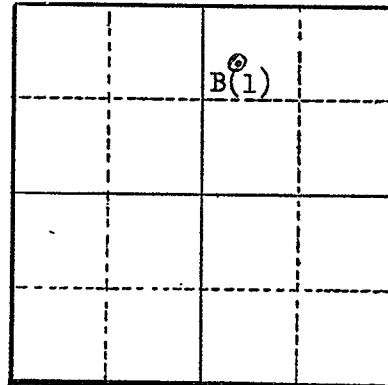

Section 9

Altitude at well 310' Interpolated

TYPE OF WELL: Drilled Date Constructed Dec. 51

Depth drilled 95' Depth cased 16'

CASING RECORD:

6 inch casing set from 0 to 16 feet
(rock from 15 to 95 feet)

FINISH:

None

AQUIFERS: Water bearing zones at 43
76
Rock from 15 to 95 feet 95 feet

WATER LEVEL:

12 feet below land surface December 14, 1951

PUMPING EQUIPMENT: Type Berkeley Turbine H.P. 5
Capacity 125 G.P.M.

WELL TESTS:

Drawdown 76 ft. after 3 1/2 hours pumping 80 G.P.M.
Drawdown ft. after hours G.P.M.

USE OF WATER Irrigation 25 acres Temp. °F. 19
SOURCE OF INFORMATION Registration Statement GR-316

DRILLER or DIGGER

ADDITIONAL DATA:

Log No. Water Level Measurements Chemical Analysis Aquifer Test

REMARKS: