

STATE ENGINEER
Salem, Oregon

CLAC
015190

Well Record


STATE WELL NO. 6/1-9F(1)
COUNTY Clackamas
APPLICATION NO. GR-295

OWNER: Harry Asboe MAILING ADDRESS: Route 1

LOCATION OF WELL: Owner's No. 1 CITY AND STATE: Mt. Angel, Oregon

SE 1/4 NW 1/4 Sec. 9 T. 6 S. R. 1 E. W., W.M.

Bearing and distance from section or subdivision corner 1100' N. & 1600' E. from W 1/4 cor. of Sec. 9

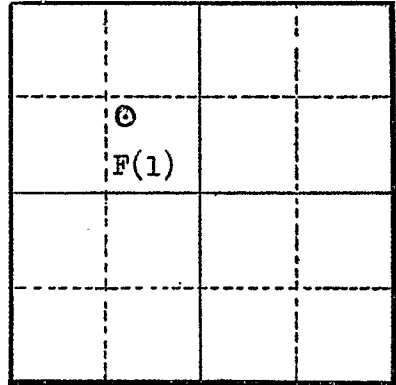

Altitude at well 300' Interpolated

TYPE OF WELL: Drilled Date Constructed June 1950

Depth drilled 200 Depth cased 16

Section 9

CASING RECORD:

8 inch open end steel casing set from 0 to 16 feet

FINISH:

None

AQUIFERS:

Rock 0 to 200 feet

WATER LEVEL:

165 feet below land surface

PUMPING EQUIPMENT: Type Berekely H.P. 10
Capacity 200 G.P.M.

WELL TESTS:

Drawdown ft. after hours G.P.M.
Drawdown ft. after hours G.P.M.

USE OF WATER Irrigation 40 acres Temp. °F. 19

SOURCE OF INFORMATION Registration Statement GR-295

DRILLER or DIGGER R. Stadeli

ADDITIONAL DATA:

Log No Water Level Measurements Chemical Analysis Aquifer Test

REMARKS: