

STATE ENGINEER
Salem, Oregon

CLAC
015738

Well Record


STATE WELL NO. 3/4-5L(1)
COUNTY Clackamas
APPLICATION NO. G-260

OWNER: Mt. Hood Hardboard & Plywood Corp. MAILING ADDRESS: _____

LOCATION OF WELL: Owner's No. _____ CITY AND STATE: _____

NE $\frac{1}{4}$ SW $\frac{1}{4}$ Sec. 5 T. 3 N. S., R. 4 W. W.M.

Bearing and distance from section or subdivision
corner s 58° 09' E 1733' from W $\frac{1}{4}$ cor. Sec. 5

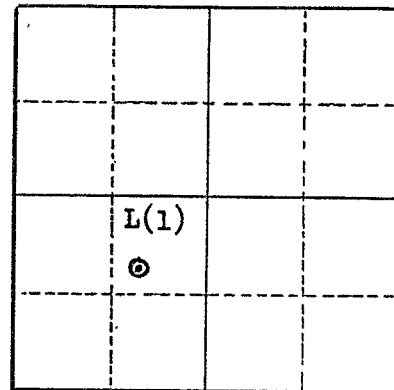

Section 5

Altitude at well _____

TYPE OF WELL: Drilled Date Constructed Jan-Feb 56

Depth drilled 275 Depth cased 195

CASING RECORD:

10 inch set from 0 to 195 feet

FINISH:

open end casing

AQUIFERS:

small gravel from 190 to 200 feet

WATER LEVEL:

90 feet below land surface, February 1956

PUMPING EQUIPMENT: Type _____ H.P. _____
Capacity _____ G.P.M. _____

WELL TESTS:

Drawdown 55 ft. after 2 hours pumping 105 G.P.M.

Drawdown 80 ft. after 10 hours pumping 120 G.P.M.

USE OF WATER Log pond Temp. _____ °F. _____, 19____

SOURCE OF INFORMATION Well drillers report

DRILLER or DIGGER steinman Brothers

ADDITIONAL DATA:

Log x Water Level Measurements _____ Chemical Analysis _____ Aquifer Test _____

REMARKS:

State Well No. 3/4-5L(1)
County Clackamas
Application No. G-260

Owner: Mt. Hood Hardboard & Plywood Corp. Owner's No.

Driller: Steinman Bros. Date Drilled Jan-Feb 1956

[illegible]