

STATE ENGINEER
Salem, Oregon

CLAC
015798

Well Record


STATE WELL NO. 3/4-8F
COUNTY CLACKAMAS
~~APPLICATION NO.~~ GR-2666

OWNER: Harvey Barnard MAILING ADDRESS: Rt. 1, Box 40

LOCATION OF WELL: Owner's No. _____ CITY AND STATE: Estacada, Oregon

SE 1/4 NW 1/4 Sec. 8 T. 3 N. S., R. 4 E. W, W.M.

Bearing and distance from section or subdivision corner N. 50° 54' E. 1348' from angle corner in the South line of the John B. Chiles DIC.

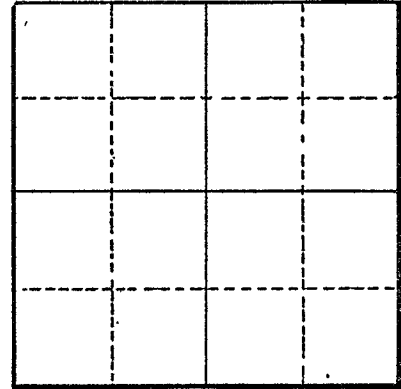

Section _____

Altitude at well _____

TYPE OF WELL: Drilled Date Constructed 1951

Depth drilled 500 Depth cased 500

CASING RECORD:

12-inch
8-inch

FINISH:

6" pipe perforated with Mills Knife perforator from 57' to 65'
Four perforations per foot 1/4" wide by 1 1/2" long.

AQUIFERS:

WATER LEVEL:

73-feet

PUMPING EQUIPMENT: Type F. M. Pomona H.P. 15
Capacity 125 G.P.M.

WELL TESTS:

Drawdown 224 ft. after _____ hours Pumping 125 G.P.M.
Drawdown _____ ft. after _____ hours _____ G.P.M.

USE OF WATER Irrigation Temp. _____ °F., 19 _____

SOURCE OF INFORMATION GR-2527
DRILLER or DIGGER A. M. Jamsen, Aloha, Ore. - Steinman Bros. Reworked well

ADDITIONAL DATA:

Log _____ Water Level Measurements _____ Chemical Analysis _____ Aquifer Test _____

REMARKS: