

STATE ENGINEER
Salem, Oregon

CLAC
16475

Well Record


STATE WELL NO. 3/3-5G(1)
COUNTY Clackamas
APPLICATION NO. GR-275

OWNER: Washore Turkey Association
MAILING ADDRESS: 920 S. E. Stark

LOCATION OF WELL: Owner's No. 1
CITY AND STATE: Portland 14, Oregon

SW 1/4 NE 1/4 Sec. 5 T. 3 N. S., R. 3 W., W.M.

Bearing and distance from section or subdivision
corner 500' North and 700' East from center of
Section 5

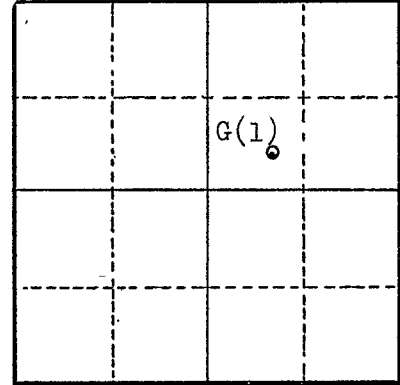

Section 5

Altitude at well 124' Interpolated

TYPE OF WELL: Drilled Date Constructed 7/15/55

Depth drilled 250 Depth cased 50

CASING RECORD:

8-inch casing set from 0 to 50 feet

FINISH:

unknown

AQUIFERS:

Sands - 94 to 105 and (150 to 206? feet)
(rock)

WATER LEVEL:

215 feet (questionable)

PUMPING EQUIPMENT: Type Johnston turbine H.P. 5
Capacity 40 G.P.M.

WELL TESTS:

Drawdown 53 ft. after hours pumping 47 G.P.M.
Drawdown 42 ft. after hours pumping 40 G.P.M.

USE OF WATER Irrigation 14.7 acres Temp. °F., 19

SOURCE OF INFORMATION Registration statement GR-275

DRILLER or DIGGER O. E. Janssen Drilling Co. Box 38, Clackamas, Oregon

ADDITIONAL DATA:

Log Yes Water Level Measurements Chemical Analysis Aquifer Test

REMARKS:

