

STATE ENGINEER
Salem, Oregon

CLAC
~~17297~~
Well Record
CLAC
17297

STATE WELL NO. 3/2-8D(1)
COUNTY Clackamas
APPLICATION NO. GR-723

OWNER: Rudolph Pavlinac

MAILING ADDRESS: Rt. 1, Box 690

LOCATION OF WELL: Owner's No. 1

CITY AND STATE: Oregon City, Oregon

NW 1/4 NW 1/4 Sec. 8 T. 3 S., R. 2 E., W.M.

Bearing and distance from section or subdivision corner S. 59° E. 1405 ft. from NW Cor. Sec. 8

X		

Section 8

Altitude at well 425 ft. Interpolated

TYPE OF WELL: Drilled Date Constructed 2/15/53

Depth drilled 405 ft. Depth cased 405 ft.

CASING RECORD: 8 in. from ground level to 405 ft.

FINISH:

AQUIFERS:

WATER LEVEL: 260 ft.

PUMPING EQUIPMENT: Type Berkeley turbine 5" electric H.P. 30
Capacity 225 G.P.M.

WELL TESTS:
Drawdown 80 ft. after 300 hours G.P.M.
Drawdown ft. after hours G.P.M.

USE OF WATER Irrigation Temp. °F. 19

SOURCE OF INFORMATION GR-723

DRILLER or DIGGER Steinett

ADDITIONAL DATA:

Log X Water Level Measurements Chemical Analysis Aquifer Test

REMARKS:

STATE ENGINEER
Salem, Oregon

CLAG
17297

Well Record

STATE WELL NO. 3/2-8D(1)
COUNTY Clackamas
APPLICATION NO. GR-723


OWNER: Rudolph Paylinac
MAILING ADDRESS: Route 1, Box 690
CITY AND STATE: Oregon City, Oregon

LOCATION OF WELL: Owner's No. #1
NW 1/4 NW 1/4 Sec. 8 T. 3 S, R. 2 W., W.M.

Bearing and distance from section or subdivision
corner S 59° E 1405 Feet from NW corner of
Section 8

Altitude at well 425 feet Interpolated

TYPE OF WELL: Drilled Date Constructed 2/15/53
Depth drilled 405 feet Depth cased 405 feet

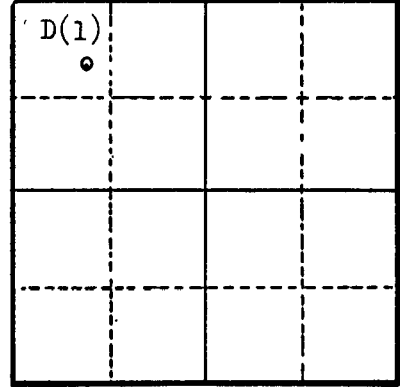

Section 8

CASING RECORD:

8-inch from ground level to 405 feet

FINISH:

AQUIFERS:

WATER LEVEL:

260 feet

PUMPING EQUIPMENT: Type Berkley turbine 5" electric H.P. 30
Capacity 225 G.P.M.

WELL TESTS:

Drawdown 80 ft. after 300 hours G.P.M.
Drawdown ft. after hours G.P.M.

USE OF WATER Irrigation Temp. °F. 19

SOURCE OF INFORMATION GR-723
DRILLER or DIGGER Steinett

ADDITIONAL DATA:

Log Water Level Measurements Chemical Analysis Aquifer Test

REMARKS: