

STATE ENGINEER
Salem, Oregon

CLAG
17317

Well Record

STATE WELL NO. 3/2-9C
COUNTY Clackamas
APPLICATION NO. GR-997

GR- 1548

OWNER: The J. M. Smucker Company

MAILING ADDRESS: P. O. Box 87

LOCATION OF WELL: Owner's No.

CITY AND STATE: Oregon City, Oregon


NE 1/4 NW 1/4 Sec. 9 T. 3 S., R. 2 E. W.M.

Bearing and distance from section or subdivision corner Beginning S. 89° W. 1454.6' from NE. cor. of R. Caufield DLC. thence N. 3° 54' E. 722.08' to S. line of Mkt. Rd. #11 thence S 32° 35' W. 50' to the well.

Altitude at well 500'

TYPE OF WELL: Drilled Date Constructed 1948

Depth drilled 390' Depth cased 350'

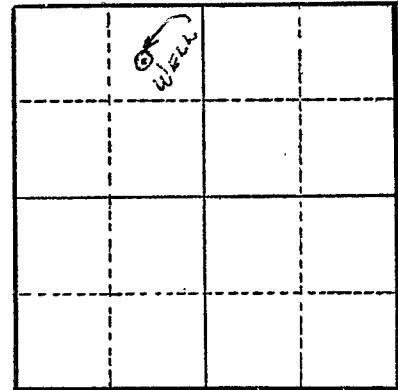

Section 9

CASING RECORD:

12" pipe from 0 to 23 ft.
8" pipe from 0 to 350 ft.

FINISH:

8" pipe perforated - 2 rows of slots (1/4" x 1 1/2") 5/ft. from 62 to 347 ft.

AQUIFERS:

WATER LEVEL:

120'

PUMPING EQUIPMENT: Type Peerless - Conical - 4" H.P. 20
Capacity 140 G.P.M.

WELL TESTS:

Drawdown 210 ft. after hours 140 G.P.M.
Drawdown 235 ft. after hours 150 G.P.M.

USE OF WATER Industrial Temp. °F. 19

SOURCE OF INFORMATION GR Record

DRILLER or DIGGER

ADDITIONAL DATA:

Log X Water Level Measurements Chemical Analysis Aquifer Test

REMARKS:

