

STATE ENGINEER  
Salem, Oregon

CLAC  
17491

## Well Record

STATE WELL NO. 3/2-20Q(1)  
COUNTY Clackamas  
APPLICATION NO. GR-252


OWNER: A. G. Riehle MAILING ADDRESS: Route 1, Box 635

LOCATION OF WELL: Owner's No. CITY AND STATE: Oregon City, Oregon

SW 1/4 SE 1/4 Sec. 20 T. 3 N. S, R. 2 E W, W.M.

Bearing and distance from section or subdivision

corner 485' N. & 175' E from NW cor. Sec. 20

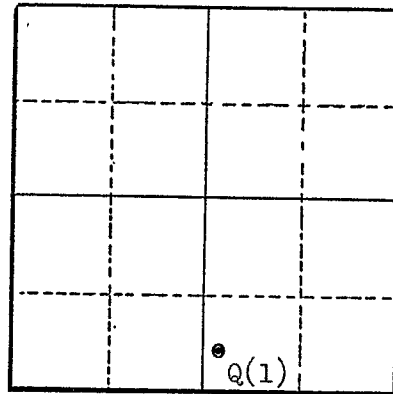

Section 20

Altitude at well 420

TYPE OF WELL: Drilled Date Constructed Dec. 1950

Depth drilled 407 Depth cased 407

### CASING RECORD:

6-inch

### FINISH:

### AQUIFERS:

### WATER LEVEL:

180

PUMPING EQUIPMENT: Type Rotary Deep well H.P. 20  
Capacity 80 G.P.M.

### WELL TESTS:

Drawdown ft. after hours G.P.M.

Drawdown ft. after hours G.P.M.

USE OF WATER Irrigation Temp. °F. 19

SOURCE OF INFORMATION Ground Water Registration Record

DRILLER or DIGGER J. W. Beck; canby, Oregon

### ADDITIONAL DATA:

Log No. Water Level Measurements Chemical Analysis Aquifer Test

### REMARKS: