


RECEIVED

FEB 26 1992

WATER RESOURCES DEPT.
SALEM, OREGON

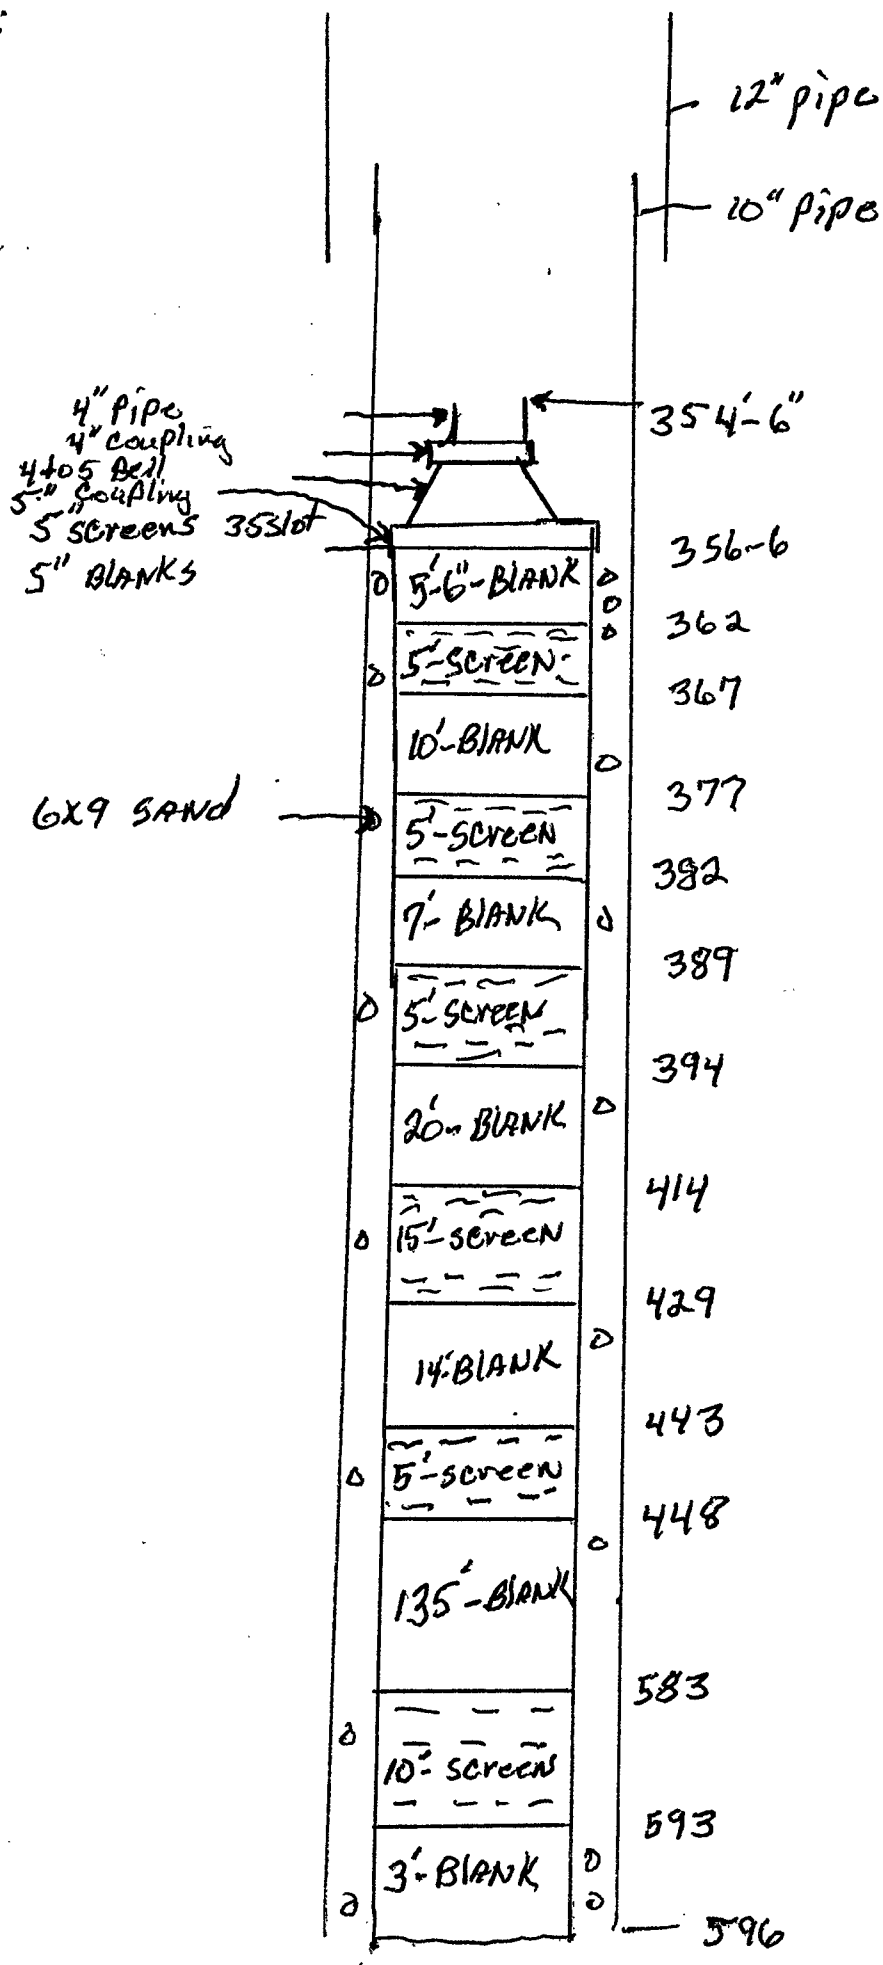

4" pipe
4" coupling
4x5 Bell
5" coupling
5 screens
5" BLANKS

6x9 SAND

353'

354'-6"

356-6

362

367

377

382

389

394

414

429


443

448

583

593

596

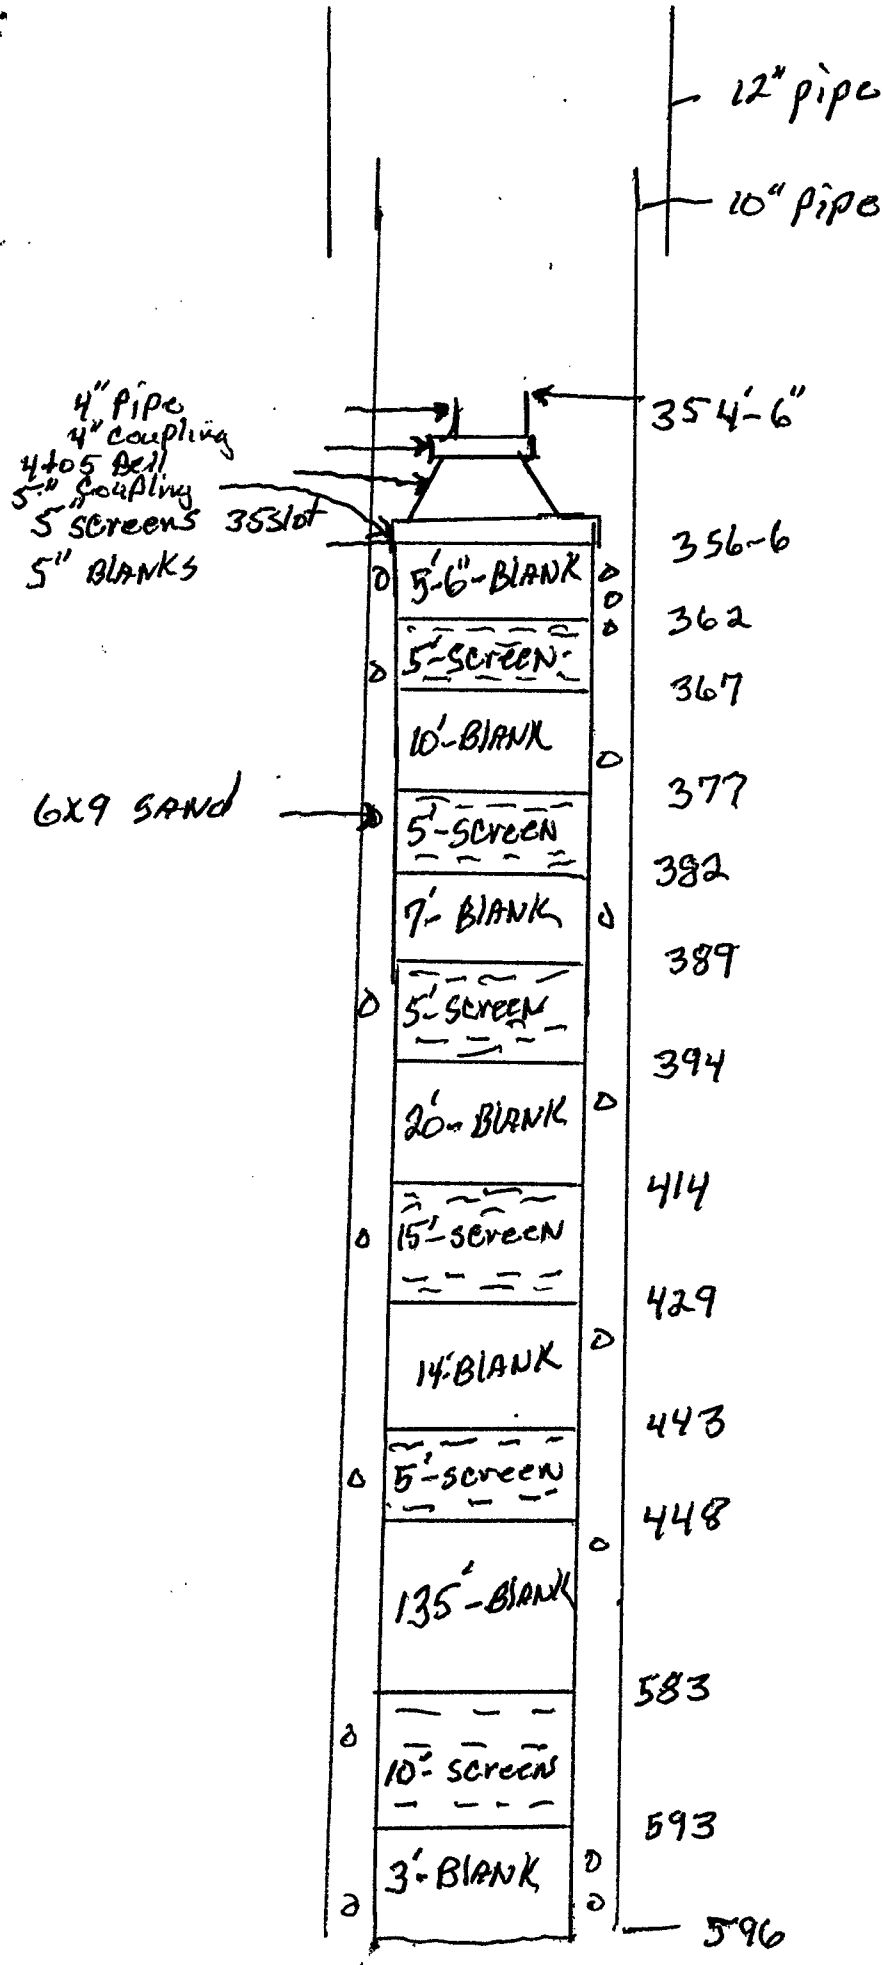

4" pipe
 4" coupling
 4 to 5 Bell
 5" coupling
 5 screens
 5" BLANKS

6x9 SAND

354'-6"

356-6

362

367

377

382

389

394

414

429

443

448

583

593

596