

STATE ENGINEER  
Salem, Oregon

CLAG  
C1998

# Well Record

STATE WELL NO. 4/1W-36H  
COUNTY Clackamas  
APPLICATION NO. GR-4145

OWNER: Floyd Lenhardt


MAILING ADDRESS: Route 1, Box 77

LOCATION OF WELL: Owner's No. \_\_\_\_\_

CITY AND STATE: Hubbard, Oregon

SE  $\frac{1}{4}$  NE  $\frac{1}{4}$  Sec. 36 T. 4 S., R. 1 W., W.M.

Bearing and distance from section or subdivision  
corner 610' S. & 40° 0' W. to SW Cor. Sec. 36

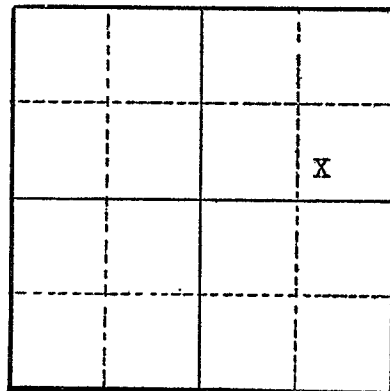

Section 36

Altitude at well \_\_\_\_\_

TYPE OF WELL: Drilled Date Constructed 1940

Depth drilled 131 ft. Depth cased \_\_\_\_\_

### CASING RECORD:

### FINISH:

### AQUIFERS:

### WATER LEVEL:

60 feet below surface

PUMPING EQUIPMENT: Type Pamona H.P. 7½  
Capacity 100 G.P.M.

### WELL TESTS:

Drawdown 30 ft. after \_\_\_\_\_ hours 100 G.P.M.

Drawdown \_\_\_\_\_ ft. after \_\_\_\_\_ hours \_\_\_\_\_ G.P.M.

USE OF WATER Irrigation Temp. \_\_\_\_\_ °F. \_\_\_\_\_, 19\_\_\_\_

SOURCE OF INFORMATION Well Registration Statement Cert. # GR-3718

DRILLER or DIGGER Peter Harnick (deceased)

### ADDITIONAL DATA:

Log \_\_\_\_\_ Water Level Measurements \_\_\_\_\_ Chemical Analysis \_\_\_\_\_ Aquifer Test \_\_\_\_\_

### REMARKS: