

STATE ENGINEER
Salem, Oregon

CLAG
02075

Well Record

STATE WELL NO. 5/W-12B
COUNTY CLACKAMAS
APPLICATION NO. GR-2564

OWNER: L. J. Schwabauer


MAILING ADDRESS: Rt. 1, Box 196

LOCATION OF WELL: Owner's No.

CITY AND STATE: Hubbard, Oregon

NW 1/4 NE 1/4 Sec. 12 T. 5 S., R. 1 W., W.M.

Bearing and distance from section or subdivision corner S. 57° W. 2390'

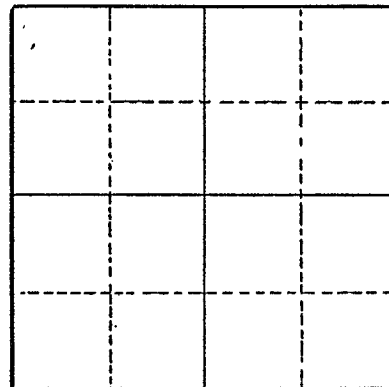

Section

Altitude at well

TYPE OF WELL: Drilled Date Constructed 1952

Depth drilled 410 Depth cased 410

CASING RECORD:

10-inch

FINISH:

5 slots from 114 to 134
5 slots from 355 to 396

AQUIFERS:

Gravel and sand

WATER LEVEL:

PUMPING EQUIPMENT: Type Johnson Turbine H.P. 40
Capacity 800 G.P.M.

WELL TESTS:

Drawdown 130 ft. after hours Pumping 320 G.P.M.
Drawdown 160 ft. after hours Pumping 600 G.P.M.

USE OF WATER Irrigation Temp. °F., 19

SOURCE OF INFORMATION GR-2423
DRILLER or DIGGER J. W. Beck, Box 54, Canby, Oregon

ADDITIONAL DATA:

Log X Water Level Measurements Chemical Analysis Aquifer Test

REMARKS:

Water bearing gravel from 114 to 134 feet
Water bearing sand from 355 to 396 feet