

STATE ENGINEER  
Salem, Oregon

CLAC Well Record  
02077


STATE WELL NO. 5/1W-12L  
COUNTY Clackamas  
APPLICATION NO. GR-4052

OWNER: Herbert R. Hawley  
MAILING ADDRESS: Route 1 Box 190

LOCATION OF WELL: Owner's No. \_\_\_\_\_  
CITY AND STATE: Hubbard, Oregon

NE 1/4 SW 1/4 Sec. 12 T. 5 S., R. 1 W., W.M.

Bearing and distance from section or subdivision  
corner 1800' E. & 1350' N. from SW Cor. Sec. 12

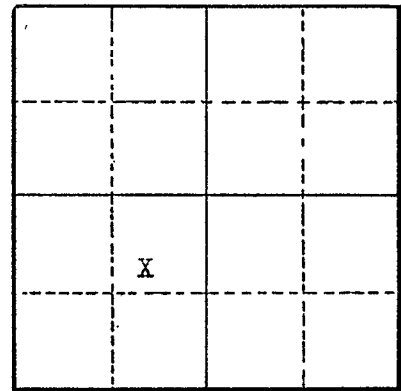

Section 12

Altitude at well \_\_\_\_\_

TYPE OF WELL: Drilled Date Constructed 5/15/43

Depth drilled 100 ft. Depth cased 100 ft.

CASING RECORD:

6 inch steel casing set to 100 feet

FINISH:

AQUIFERS:

WATER LEVEL:

20 feet below surface

PUMPING EQUIPMENT: Type Pomona turbine H.P. 7 1/2

Capacity 100 G.P.M.

WELL TESTS:

Drawdown 45 ft. after \_\_\_\_\_ hours 100 G.P.M.

Drawdown \_\_\_\_\_ ft. after \_\_\_\_\_ hours \_\_\_\_\_ G.P.M.

USE OF WATER Irrigation Temp. \_\_\_\_\_ °F., 19

SOURCE OF INFORMATION Well Registration Statement Cert. # GR-3652

DRILLER or DIGGER \_\_\_\_\_

ADDITIONAL DATA:

Log \_\_\_\_\_ Water Level Measurements \_\_\_\_\_ Chemical Analysis \_\_\_\_\_ Aquifer Test \_\_\_\_\_

REMARKS: