

STATE ENGINEER
Salem, Oregon

CLAC
02112
Well Record

STATE WELL NO. 5/1W-13R
COUNTY CLACKAMAS
~~APPLICATION NO.~~ GR-2468

OWNER: Raymond M. Schneider


MAILING ADDRESS: _____

LOCATION OF WELL: Owner's No. _____

CITY AND STATE: Monitor, Oregon

SE 1/4 SE 1/4 Sec. 13 T. 5 S., R. 1 W., W.M.

Bearing and distance from section or subdivision corner 1000' W. and 200' N.

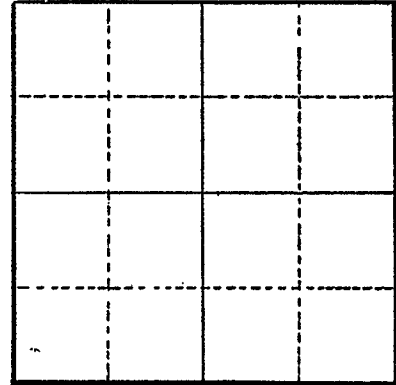

Section _____

Altitude at well _____

TYPE OF WELL: Drilled Date Constructed 1942

Depth drilled 155 Depth cased 112

CASING RECORD:

6-inch

FINISH:

AQUIFERS:

Gravel and clay

WATER LEVEL:

24-feet

PUMPING EQUIPMENT: Type Cook Turbette H.P. 3

Capacity 65 G.P.M.

WELL TESTS:

Drawdown 80 ft. after _____ hours Pumping 150 G.P.M.

Drawdown _____ ft. after _____ hours _____ G.P.M.

USE OF WATER Irrigation Temp. _____ °F. _____, 19_____

SOURCE OF INFORMATION GR-2337

DRILLER or DIGGER Byron Ballweber, Rt. 2, Woodburn, Oregon

ADDITIONAL DATA:

Log Water Level Measurements _____ Chemical Analysis _____ Aquifer Test _____

REMARKS:

At 96 to 114 ft. gravel stratum 18 59
Clay
126 to 129 ft. gravel stratum 3 21
Clay
150 to 155 ft. gravel stratum 5 --